

MAR 30 1999

APPROVED

Date 10-29-98 RRL
**CALHOUN COUNTY
REMONUMENTATION.**

**CALHOUN COUNTY REMONUMENTATION
LAND CORNER RECORDATION CERTIFICATE
Filing Requirement of Act 74, Mich. P.A. 1970**

STATE OF MICHIGAN
CALHOUN COUNTY
RECORDED

For corners in

CALHOUN
(County)
ALBION TWP.

Located In:

Corner Code #

1. Public Land Survey

T3S R4 W

K-11

T___ R___

T___ R___

T___ R___

2. Property Controlling
in Section

S___ T___ R___

S___ T___ R___

3. Miscellaneous
Property in Sec.

S___ T___ R___

S___ T___ R___

29 OCT 1998 2:43:51 PM

ANNE B. NORLANDER
CLERK - REGISTER OF DEEDS

LIBER 2073 PAGE 291

Register of Deeds Stamp & File Number

4. Lot No. _____, Recorded Plat _____

5. Private Claims _____

I, Frederick J. Cutcher, in a field survey on October 8, 1998, do hereby state that under requirements of P.A. 74, Michigan P.A. of 1970, the corner points mentioned in lines 1 and 2 above were in conformance with regulations and rules therefore as required in the current manual of survey instructions of the United States Department of the Interior, Bureau of Land Management or by a decree of a Court of Law and/or that the corner points mentioned in lines 3, 4 and 5 above were in conformance with the rules of the Michigan Board of Land Surveyors or by a Decree of a Court of Law; established, re-established, monumented, recovered, found as expressed below:

NOTE: Not more than 2 corners, all in the same town and range, may be recorded on this certificate.

	A	B	C	D	E	F	G	H	I	J	K	L	M
1													
2	6		5		4		3		2		1		
3													
4	7		8		9		10		11		12		
5													
6	18		17		16		15		14		13		
7													
8	19		20		21		22		23		24		
9													
10	30		29		28		27		26		25		
11													
12	31		32		33		34		35		36		
13													

A. Description of original monument and accessories and/or subsequent restoration:

G.L.O. by Lucius Lyon, 12/12/1825: Burr Oak 9" S 58° E 57 lks; Black Oak 7" N 63 1/2° W 82 lks.

Witness Card - Lyon, 1826: Burr Oak 9" S 58° E 57 lks; Burr Oak 7" N 63 1/2° W 82 lks.

Witness Card - T.P.J., date unknown: Chisled "x" on rock; 3' W. of centerline South; 2' S. of centerline E-W; 22" deep from old witness tree (now stump) S.E.; 24" Oak N 55° W 52.30'; U.P. S 60° W 55.42'; 24" Oak S 40° W 41.25.

Witness Card - Gertz, 8/31/83: Found pipe over large rock with chisled "x" in top; 24" Oak N 55° W 53.18'; U.P. S 60° W 55.42'; 24" Oak S 40° W 41.23'; 2± South of E-W centerline; 5± West of N-S centerline.

B. Description of corner evidence found and/or method applied in restoring or reestablishing corner:

On 10/8/98 found 3/4" x 14" iron pipe over stone with brick from Gertz's references of 8/31/88 (all references remain).

C. Description of monument for corner and accessories established to perpetuate locating the position of the corner:

Replaced stone and pipe with Berntsen monument in a monument box and is accepted as a careful and faithful reestablishment of the position of the original corner.

5' West of centerline N-S road; in line with centerline to West; 3' South of centerline to East.

Found nail & spotter N. side 30" Oak N 50° W 53.12'


Set nail & spotter S.E. side 6" Oak N 35° E 64.39'

Set nail & spotter N. side 36" Oak S 40° W 41.05'

Found nail & spotter N. side util. pole S 60° W 55.45'

Signed by Frederick J. Cutcher
Surveyor's Michigan License No. 24592

Date 10/19/98

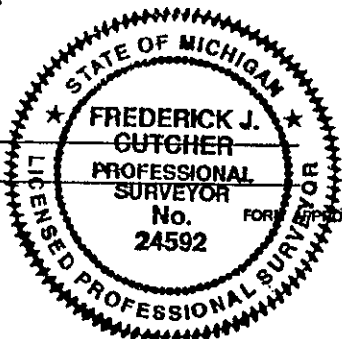

FOR APPROVED BY MICHIGAN STATE BOARD OF PROFESSIONAL SURVEYORS, JAN. 28, 197
REVISED MAY 14, 197
REVISED JAN., 198
REVISED OCT., 199