

APPROVED

Date 9-15-99 *RLC*

CALHOUN COUNTY REMONUMENTATION.

CALHOUN COUNTY REMONUMENTATION LAND CORNER RECORDATION CERTIFICATE Filing Requirement of Act 74, Mich. P.A. 1970

STATE OF MICHIGAN
CALHOUN COUNTY
RECORDED

29 SEP 1999 10:31:45 AM

ANNE B. MORLANDER
CLERK - REGISTER OF DEEDS

LIBER **2164** PAGE **716**

Register of Deeds Stamp & File Number

For corners in

<u>CALHOUN</u> (County)	Located in:	Corner Code #
ALBION	<u>T.3S R.4W</u>	<u>M-12</u>
1. Public Land Survey	T <u> </u> R <u> </u>	<u> </u>
	T <u> </u> R <u> </u>	<u> </u>
	T <u> </u> R <u> </u>	<u> </u>
2. Property Controlling In Section	S <u> </u> T <u> </u> R <u> </u>	<u> </u>
	S <u> </u> T <u> </u> R <u> </u>	<u> </u>
3. Miscellaneous Property in Sec.	S <u> </u> T <u> </u> R <u> </u>	<u> </u>
	S <u> </u> T <u> </u> R <u> </u>	<u> </u>

4. Lot No. _____, Recorded Plat _____
5. Private Claims _____

I, Michael A. Groat, in a field survey on September 12, 1999, do hereby state that under requirements of P.A. 74, Michigan P.A. of 1970, the corner points mentioned in lines 1 and 2 above were in conformance with regulations and rules therefore as required in the current manual of survey instructions of the United States Department of the Interior, Bureau of Land Management or by a decree of a Court of Law and/or that the corner points mentioned in lines 3, 4 and 5 above were in conformance with the rules of the Michigan Board of Land Surveyors or by a Decree of a Court of Law, established, re-established, monumented, recovered, found as expressed below:

NOTE: Not more than 2 corners, all in the same town and range, may be recorded on this certificate.

	A	B	C	D	E	F	G	H	I	J	K	L	M
2													
3													
A. Description of original monument and accessories and/or subsequent restoration:

ORIGINAL SURVEY BY LUCIUS LYON, DEPUTY SURVEYOR, 1825, SET POST 12" HICKORY, S 31° W, 40 LINKS AND 12" HICKORY, N 34° W, 75 LINKS.

SURVEY &
REMONUMENTATION

MAR 18 2000

B. Description of corner evidence found and/or method applied in restoring or reestablishing corner:

SECTION


FOUND 1/2" IRON IN ROAD 10' NORTH OF FENCE EAST, 5' SOUTH OF FENCE WEST. MEASURES MID WAY BETWEEN CORNERS NORTH AND SOUTH. EXCAVATED AND FOUND LARGE STONE 1.5' DEEP. ACCEPTED THE LOCATION OF THE IRON AS THE BEST EVIDENCE OF THE LOCATION OF THE ORIGINAL MONUMENT.

C. Description of monument for corner and accessories established to perpetuate locating the position of the corner:

SET BERNTSEN MONUMENT & MONUMENT BOX IN PLACE OF IRON.
1/2" IRON, WEST, 32.85'
SET NAIL & TAG IN 15" WHITE OAK, N 60° W, 33.05 FEET
SET NAIL & TAG IN 10" MAPLE, N 40° E, 45.44 FEET
SET NAIL & TAG IN 20" OAK, S 30° E, 47.22 FEET
SET NAIL & TAG IN 10" OAK, S 40° W, 50.75 FEET

Signed by *Michael A. Groat*
Surveyor's Michigan License No. 39079

Date September 15, 1999

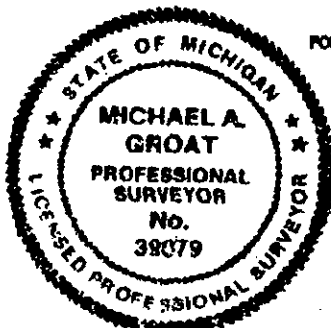

FORM APPROVED BY MICHIGAN STATE BOARD OF PROFESSIONAL SURVEYORS, JAN. 26, 1971
REVISED MAY 14, 1978
REVISED JAN. 1983
REVISED OCT., 1986