

**SURVEY &
REMONUMENTATION**

MAR 21 1997

COMMISSION

APPROVED
Date July 17 1996
**CALHOUN COUNTY
REMONUMENTATION.**

**CALHOUN COUNTY REMONUMENTATION
LAND CORNER RECORDATION CERTIFICATE**
Filing Requirement of Act 74, Mich. P.A. 1970

STATE OF MICHIGAN
CALHOUN COUNTY
RECORDED

24 JUL 96 2:03 P.M.

WINE D. NORLANDER
CLERK - REGISTER OF DEEDS

Register of Deeds Stamp & File Number

For corners in

<u>Calhoun</u> <small>(County)</small>	Located In:	Corner Code #
Eckford Township	T <u>3S</u> R <u>5W</u>	C-2
1. Public Land Survey	T _____ R _____	_____
	T _____ R _____	_____
	T _____ R _____	_____
2. Property Controlling in Section	S T R	
	S T R	
3. Miscellaneous Property in Sec.	S I R	
	S T R	
4. Lot No. _____, Recorded Plat _____		
5. Private Claims _____		

A	B	C	D	E	F	G	H	I	J	K	L	M
2	6	5	4	3	2	1						
3												
4	7	8	9	10	11	12						
5												
6	18	17	16	15	14	13						
7												
8	19	20	21	22	23	24						
9												
10	30	29	28	27	26	25						
11												
12	31	32	33	34	35	36						
13												

William K. Crane in a field survey on June 29, 1996
do hereby certify that under requirements of P.A. 74, Michigan P.A. of 1970, the corner points mentioned
in lines 1 and 2 above were in conformance with regulations and rules therefore as required in the
current manual of survey instructions of the United States Department of the Interior, Bureau of Land
Management or by a decree of a Court of Law and/or that the corner points mentioned in lines 3, 4 and 5
above were in conformance with the rules of the Michigan Board of Land Surveyors or by a Decree of a
Court of Law; established, re-established, monumented, re-monumented, recovered, found as
expressed below:

**NOTE: Not more than 4 corners, all in the same town and range, may be recorded
on this certificate.**

A. Description of original monument and accessories and/or subsequent restoration:

G.L.O. Survey by Lucius Lyon, Deputy Surveyor

10" White Oak S 32° E 20 links
10" DO S 35° W 27 links

Dekeyser & Associates, 1978

"T" iron far off road by house to rear
NE corner garage N 70° W 42.72'
NE corner house S 40° W 23.90'
4"± North of tree line East
At South edge of drive
In line with East edge of pole barn to
North - 30" Maple S 85° E 33.87'

3. Description of corner evidence found and/or method applied in restoring or reestablishing corner:


Found "T" iron mentioned above, dug and found large pointed stone with pieces of brick

LIBER 1876 PAGE 200

2. Description of monument for corner and accessories established to perpetuate locating the position of the corner:

Replaced "T" iron and stone with Standard Calhoun County Remonumentation monument (Bernsten Monument).

Northeast corner of garage N 70° W 42.72'
Northeast corner of house S 40° W 23.90'
4'± North of tree line East
At South edge of drive
Nail South side of 12" Twin Maple S 70° E 22.66'
Nail North side of 28" Maple N 60° W 25.55'

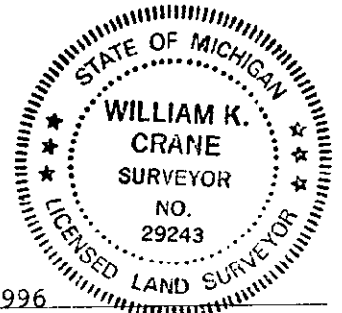

Signed by William K. Crane Date July 17, 1996
Surveyor's Michigan License No. # 29243