

APPROVED

Date SEPT 12, 1996
CALHOUN COUNTY
REMONUMENTATION.

For corners in

Calhoun (County)	Located In:	Corner Code #
Eckford Township		
1. Public Land Survey	T <u>3</u> S R <u>5</u> W	<u>C-3</u>
	T _____ R _____	_____
	T _____ R _____	_____
	T _____ R _____	_____
2. Property Controlling in Section	S _____ T _____ R _____	_____
	S _____ T _____ R _____	_____
3. Miscellaneous Property in Sec.	S _____ T _____ R _____	_____
	S _____ T _____ R _____	_____

4. Lot No. _____, Recorded Plat _____
5. Private Claims _____

I, William K. Crane, in a field survey on August 17, 19 96, do hereby certify that under requirements of P.A. 74, Michigan P.A. of 1970, the corner points mentioned in lines 1 and 2 above were in conformance with regulations and rules therefore as required in the current manual of survey instructions of the United States Department of the Interior, Bureau of Land Management or by a decree of a Court of Law and/or that the corner points mentioned in lines 3, 4 and 5 above were in conformance with the rules of the Michigan Board of Land Surveyors or by a Decree of a Court of Law; established, re-established, monumented, re-monumented, recovered, found as expressed below:

NOTE: Not more than 4 corners, all in the same town and range, may be recorded on this certificate.

A. Description of original monument and accessories and/or subsequent restoration:

Original Government Survey, Lucuis Lyon, 1825

18" B. Oak N 84½ W 54 Links
14" W. Oak S 67 E 45 Links

Corner used in a survey recorded by DeKeyser and Associates, Inc. 8/24/78 in Liber 1179, P.273 & 274

REROD:

12' East of fence South at South edge of pavement.
Capped iron East 12.00'

30" Maple S 50 W 16.2'
28" Maple N 05 W 31.15'
28" Maple S 80 E 27.3'
NE Corner HSE FDN 53.1' NW Corner HSE FDN 76.2'

B. Description of corner evidence found and/or method applied in restoring or reestablishing corner:

Found the rerod as indicated by the recorded survey and the witnesses from the records of Dekeyser and Associates Inc. As shown in part "A" Above.


LIBER 1887 PAGE 981

C. Description of monument for corner and accessories established to perpetuate locating the position of the corner:

Replaced the rerod with Standard Calhoun County Remonumentation Monument (Harrison Marker) and a monument box in gravel at South edge of pavement for B Drive South.

Capped Iron East 12.00'
Nail & Remon Cap S 50° W 16.12'
S. Side
30" Maple
Nail & Remon Cap S 80° E 26.52'
W. Side
30" Maple
NE Cor FNDN. HSE. # S 45° W 53.10'
19012
FD. P.K. Nail E. Side N 30° E 37.77'
20" Oak

This is accepted as the best available evidence of the position of the original corner.

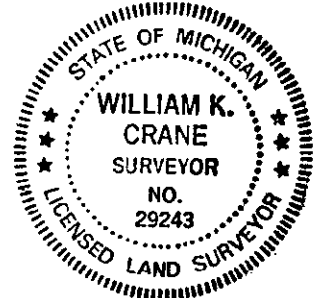

Signed by William K. Crane Date August 20, 1996

Surveyor's Michigan License No. William K. Crane # 29243

SURVEY &
REMONUMENTATION

MAR 21 1997


COMMISSION

STATE OF MICHIGAN
CALHOUN COUNTY
RECORDED

24 SEP 96 11:00 A.M.

ANNE B. NORLANDER
CLERK - REGISTER OF DEEDS

Register of Deeds Stamp & File Number

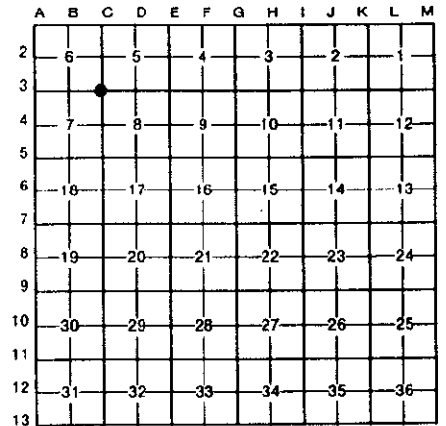

Eckford Township