

APPROVED

Date 11-12-96
CALHOUN COUNTY
REMONUMENTATION.
For corners in

CALHOUN COUNTY REMONUMENTATION
LAND CORNER RECORDATION CERTIFICATE
Filing Requirement of Act 74, Mich. P.A. 1970

STATE OF MICHIGAN
CALHOUN COUNTY
RECORDED

19 FEB 97 3:46 P.M.

ANNE B. NORLANDER
CLERK - REGISTER OF DEEDS

LIBER 1916 PAGE 97

Register of Deeds Stamp & File Number

Calhoun	Located In:	Corner Code #
(County) Eckford Township		
1. Public Land Survey	T <u>3</u> S <u>R</u> 5 W	<u>F-9</u>
	T ___ R ___	_____
	T ___ R ___	_____
	T ___ R ___	_____
2. Property Controlling in Section	S ___ T ___ R ___	_____
	S ___ T ___ R ___	_____
3. Miscellaneous Property in Sec.	S ___ T ___ R ___	_____
	S ___ T ___ R ___	_____

4. Lot No. _____, Recorded Plat _____
5. Private Claims _____

I, William K. Crane, in a field survey on November 5, 1996 do hereby state that under requirements of P.A. 74, Michigan P.A. of 1970, the corner points mentioned in lines 1 and 2 above were in conformance with regulations and rules therefore as required in the current manual of survey instructions of the United States Department of the Interior, Bureau of Land Management or by a decree of a Court of Law and /or that the corner points mentioned in lines 3, 4 and 5 above were in conformance with the rules of the Michigan Board of Land Surveyors or by a Decree of a Court of Law, established, re-established, monumented, recovered, found as expressed below.

NOTE: Not more than 2 corners, all in the same town and range, may be recorded on this certificate.

	A	B	C	D	E	F	G	H	I	J	K	L	M
1													
2	6		5		4		3		2		1		
3													
4	7		8		9		10		11		12		
5													
6	10		17		16		15		14		13		
7													
8	19		20		21		22		23		24		
9													
10	30		29		28		27		26		25		
11													
12	31		32		33		34		35		36		
13													

A. Description of original monument and accessories and/or subsequent restoration:

Original Government Survey, Lucuis Lyon, 1825:
9" White Oak S 89-3/4° E 90 links
9" D. Oak S 11° W 65 links

No other history found on this corner.

SURVEY &
REMONUMENTATION

APR 07 1998

B. Description of corner evidence found and/or method applied in restoring or reestablishing corner:

SECTION


Found pointed stone in line with fence East and West and 1.0 East of fence North.

C. Description of monument for corner and accessories established to perpetuate locating the position of the corner:

Replaced pointed stone with Standard Calhoun County Remonumentation Monument (Berntsen Monument).

Set Nail & spotter	W side of 6" Hickory	N 30° E	18.03'
Set Nail & spotter	NE side of 6" Hickory	N 74° E	8.27'
Set Nail & spotter	NE side of 4" Hickory	S 36° E	9.44'
Set Nail & spotter	NW side of 24" Cherry	S 32° W	4.44"

This is accepted as the best available evidence of the position of the original corner.

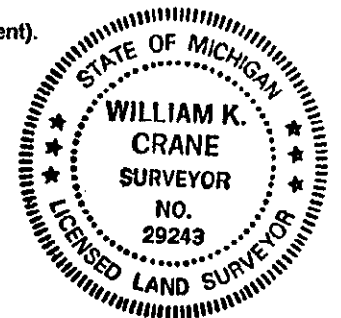

Signed by William K. Crane

William K. Crane, P.S.

Date January 31, 1997

Surveyor's Michigan License No. 29243