

APPROVED

Date 12/8/99 RRC
CALHOUN COUNTY
REMONUMENTATION.

For corners in

CALHOUN COUNTY REMONUMENTATION
LAND CORNER RECORDATION CERTIFICATE
Filing Requirement of Act 74, Mich. P.A. 1970

STATE OF MICHIGAN
CALHOUN COUNTY
RECORDED

17 DEC 1999 2:34:27 PM

MINE B. NORLANDER
CLERK - REGISTER OF DEEDS

LIBER 2185 PAGE 993

Register of Deeds Stamp & File Number

<u>CALHOUN</u>	Located In:	Corner Code #
(County)		
ECKFORD TOWNSHIP	T <u>3S</u> R <u>5W</u>	<u>F-13</u>
1. Public Land Survey	T _____ R _____	_____
	T _____ R _____	_____
	T _____ R _____	_____
2. Property Controlling	S _____ T _____ R _____	_____
in Section	S _____ T _____ R _____	_____
3. Miscellaneous	S _____ T _____ R _____	_____
Property in Sec.	S _____ T _____ R _____	_____

4. Lot No. _____, Recorded Plat _____
5. Private Claims _____

I, Michael A. Groat, in a field survey on December 6, 1999 do hereby state that under requirements of P.A. 74, Michigan P.A. of 1970, the corner points mentioned in lines 1 and 2 above were in conformance with regulations and rules therefore as required in the current manual of survey instructions of the United States Department of the Interior, Bureau of Land Management or by a decree of a Court of Law and for that the corner points mentioned in lines 3, 4 and 5 above were in conformance with the rules of the Michigan Board of Land Surveyors or by a Decree of a Court of Law; established, re-established, monumented, recovered, found as expressed below:

NOTE: Not more than 2 corners, all in the same town and range, may be recorded on this certificate.

A	B	C	D	E	F	G	H	I	J	K	L	M
1												
2	6	5	4	3	2	1						
3												
4	7	8	9	10	11	12						
5												
6	18	17	16	15	14	13						
7												
8	19	20	21	22	23	24						
9												
10	30	29	28	27	26	25						
11												
12	31	32	33	34	35	36						
13												

A. Description of original monument and accessories and/or subsequent restoration:


ORIGINAL SURVEY BY LUCIUS LYON, 1825, SET POST, HICKORY, 9", N 75° E, 18 LINKS, ELM 10", N 45° W, 26 LINKS.
R.A. COURTRIGHT, 1895, IRON & BRICK, W. OAK, 18", N 1/2° W, 415 3/4 LINKS, ELM 18", S 17 1/2° E, 157 1/2 LINKS

B. Description of corner evidence found and/or method applied in restoring or reestablishing corner:

NO PHYSICAL EVIDENCE AT ROAD SURFACE FOR THIS CORNER. THERE IS A CLARENDON CORNER (F-1) IN. EXCAVATED 26.57' WEST (GOV. JOG DIST.) BUT FOUND NOTHING. MID-WAY ON LINE BETWEEN E-13 & G-13 WOULD PUT THIS CORNER 1.57 FEET WEST & 5.09 FEET SOUTH OF THE EXCAVATED LOCATION. EXCAVATED AT THIS POSITION & FOUND OLD RED BRICKS 1.5' WEST & 6.3' SOUTH OF ORIGINAL EXCAVATED POINT. ACCEPTED THE BRICK AS THE BEST EVIDENCE OF THE ORIGINAL CORNER.

C. Description of monument for corner and accessories established to perpetuate locating the position of the corner:

SET BERNTSEN MONUMENT & MONUMENT BOX
NAIL & SPOTTER IN 12" MAPLE, S 24° E, 27.70 FEET
NAIL & SPOTTER IN 24" OAK, S 75° E, 68.11 FEET
NAIL & SPOTTER IN R.R. TIE FENCE POST, N 2° E, 30.65 FEET
NAIL & SPOTTER IN 12" HICKORY, N 50° W, 49.13 FEET
NAIL & SPOTTER IN 12" ELM, N 26° E, 35.25 FEET
6' SOUTH OF CENTERLINE

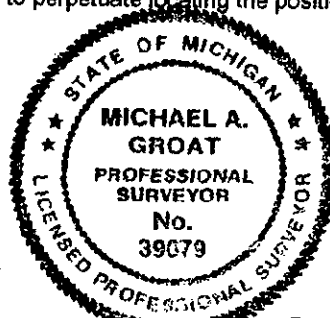

Signed by Michael A. Groat

Surveyor's Michigan License No. 39079

Date December 7, 1999

SURVEY &
REMONUMENTATION

MAR 13 2000

SECTION