

APPROVED
 Date 8-17-94
CALHOUN COUNTY
REMONUMENTATION.

CALHOUN COUNTY REMONUMENTATION
LAND CORNER RECORDATION CERTIFICATE
Filing Requirement of Act 74, Mich. P.A. 1970

STATE OF MICHIGAN
 CALHOUN COUNTY
 RECORDED

18 AUG 94 12:14 P.M.

ANNE B. NORLANDER
 CLERK - REGISTER OF DEEDS

Register of Deeds Stamp & File Number

For corners in

<u>CALHOUN</u> (County)	Located In:	Corner Code #
ECKFORD TWP	T <u>3 S</u> R <u>5 W</u>	<u>1-4</u>
1. Public Land Survey	T _____ R _____	_____
	T _____ R _____	_____
	T _____ R _____	_____
2. Property Controlling in Section	S _____ T _____ R _____	_____
	S _____ T _____ R _____	_____
3. Miscellaneous Property in Sec.	S _____ T _____ R _____	_____
	S _____ T _____ R _____	_____
4. Lot No. _____, Recorded Plat _____		
5. Private Claims _____		

A	B	C	D	E	F	G	H	I	J	K	L	M
2	6	5	4	3	2	1						
3												
4	7	8	9	10	11	12						
5												
6	18	17	16	15	14	13						
7												
8	19	20	21	22	23	24						
9												
10	30	29	28	27	26	25						
11												
12	31	32	33	34	35	36						
13												

I, ROBERT R. CARR, in a field survey on JUNE 3, 19 94, do hereby certify that under requirements of P.A. 74, Michigan P.A. of 1970, the corner points mentioned in lines 1 and 2 above were in conformance with regulations and rules therefore as required in the current manual of survey instructions of the United States Department of the Interior, Bureau of Land Management or by a decree of a Court of Law and/or that the corner points mentioned in lines 3, 4 and 5 above were in conformance with the rules of the Michigan Board of Land Surveyors or by a Decree of a Court of Law; established, re-established, monumented, re-monumented, recovered, found as expressed below:

NOTE: Not more than 4 corners, all in the same town and range, may be recorded on this certificate.

A. Description of original monument and accessories and/or subsequent restoration:

ORIGINAL CORNER SET BY DEPUTY SURVEYOR LYON 1826
 SURVEY BY COUNTY SURVEYOR B.F. WELLS 1879
 FOUND STONE 28" X 8" X 8" IN LINE WITH STONE WALL EAST

SURVEY & REMONUMENTATION

OCT 24 1994

COMMISSION


B. Description of corner evidence found and/or method applied in restoring or reestablishing corner:

FOUND 10" X 10" HEART SHAPED STONE 1.5'± DEEP, IN LINE WITH STONE ROW TO EAST
 SET BERNTSEN MONUMENT IN MONUMENT BOX OVER STONE

LIBER **1763** PAGE **776**

C. Description of monument for corner and accessories established to perpetuate locating the position of the corner:

BERNTSEN MONUMENT
 NAIL & SPOTTER WESTERLY SIDE 28" HICKORY S35°W 61.25 FT
 NAIL & SPOTTER NORTHERLY SIDE 10" CHERRY N52°W 41.08 FT
 NAIL & SPOTTER WESTERLY SIDE TWIN 12"/14" OAK S41°E 38.98 FT
 NAIL & SPOTTER WESTERLY SIDE TWIN 12"/14" OAK S20°E 55.20 FT
 IN LINE WITH STONE ROW TO EAST, IN CENTERLINE OF NORTH/SOUTH ROAD

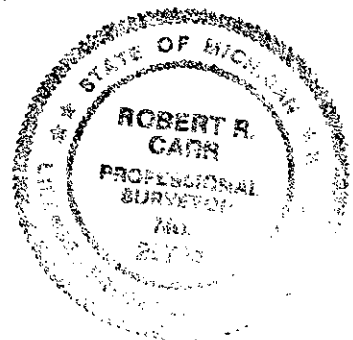

Signed by [Signature]
 Surveyor's Michigan License No. 20704

Date AUGUST 16, 1994