

APPROVED

Date 8-17-94
CALHOUN COUNTY
REMONUMENTATION.

CALHOUN COUNTY REMONUMENTATION
LAND CORNER RECORDATION CERTIFICATE
Filing Requirement of Act 74, Mich. P.A. 1970

For corners in

CALHOUN	Located In:	Corner Code #
(County)		
ECKFORD TWP		
1. Public Land Survey	T 3 S R 5 W	J-5
	T R	
	T R	
	T R	
2. Property Controlling in Section	S T R	
	S T R	
3. Miscellaneous Property in Sec.	S T R	
	S T R	
4. Lot No. _____, Recorded Plat _____		
5. Private Claims _____		

STATE OF MICHIGAN
CALHOUN COUNTY
RECORDED

18 AUG 94 12:14 P.M.

ANNE B. NORLANDER
CLERK - REGISTER OF DEEDS

Register of Deeds Stamp & File Number

I, ROBERT R. CARR, in a field survey on JUNE 3, 19 94, do hereby certify that under requirements of P.A. 74, Michigan P.A. of 1970, the corner points mentioned in lines 1 and 2 above were in conformance with regulations and rules therefore as required in the current manual of survey instructions of the United States Department of the Interior, Bureau of Land Management or by a decree of a Court of Law and/or that the corner points mentioned in lines 3, 4 and 5 above were in conformance with the rules of the Michigan Board of Land Surveyors or by a Decree of a Court of Law; established, re-established, monumented, re-monumented, recovered, found as expressed below:

NOTE: Not more than 4 corners, all in the same town and range, may be recorded on this certificate.

A. Description of original monument and accessories and/or subsequent restoration:

ORIGINAL CORNER SET BY DEPUTY SURVEYOR LYON 1826
SURVEY BY COUNTY SURVEYOR B.F. WELLS 1879
FOUND STONE 22" X 10" X 6" BR OAK 10" S36-1/2°E 59 FT
C.W. PIKE 1973
RAILROAD SPIKE
16" WALNUT S55°W 69.41 FT
6" TWIN MAPLE S45°E 47.30 FT
22" HICKORY N45°E 51.88 FT 1 FT NORTH OF CENTERLINE OF EAST/WEST ROAD
IN LINE WITH FENCE LINE NORTH/SOUTH

B. Description of corner evidence found and/or method applied in restoring or reestablishing corner:

FOUND RAILROAD SPIKE 1 FT NORTH OF CENTERLINE OF EAST/WEST ROAD
FOUND 10" OAK (NOW 40") FROM WELLS WITNESSES 1879
FOUND 16" WALNUT (STUMP)
FOUND 22" HICKORY (STUMP) & TWIN MAPLE
FOUND TWIN MAPLE (STUMP)
REPLACED SPIKE WITH BERNTSEN MONUMENT IN MONUMENT BOX

C. Description of monument for corner and accessories established to perpetuate locating the position of the corner:

BERNTSEN MONUMENT
NAIL & SPOTTER WESTERLY SIDE 40" OAK S30°E 38.68 FT
NAIL & SPOTTER EASTERLY SIDE 36" MAPLE N40°W 42.19 FT
NAIL & SPOTTER WESTERLY SIDE 30" OAK S32°W 35.88 FT
NAIL & SPOTTER EASTERLY SIDE 22" CHERRY N73°E 77.77 FT
1'± NORTH OF CENTERLINE OF EAST/WEST ROAD
1'± EAST OF FENCE LINE TO SOUTH


A	B	C	D	E	F	G	H	I	J	K	L	M
2	6	5	4	3	2	1						
3												
4	7	8	9	10	11	12						
5												
6	18	17	16	15	14	13						
7												
8	19	20	21	22	23	24						
9												
10	30	29	28	27	26	25						
11												
12	31	32	33	34	35	36						
13												

SURVEY &
REMONUMENTATION

OCT 24 1994

COMMISSION

LIBER 1763 PAGE 774

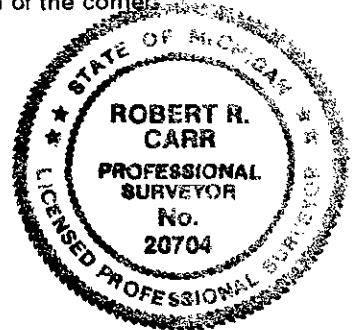

Signed by [Signature]
ROBERT R. CARR
Surveyor's Michigan License No. 20704

Date AUGUST 16, 1994