

CALHOUN COUNTY REMONUMENTATION

LAND CORNER RECORDATION CERTIFICATE  
Filing Requirement of Act 74, Mich. P.A. 1970

**APPROVED**  
Date Nov. 20 1995  
CALHOUN COUNTY  
REMONUMENTATION.

For corners in

Calhoun (County) Eckford Township	Located In:	Corner Code #
1. Public Land Survey	T <u>3</u> S R <u>5</u> W	M-5
	T _____ R _____	_____
	T _____ R _____	_____
	T _____ R _____	_____
2. Property Controlling in Section	S _____ T _____ R _____	_____
	S _____ T _____ R _____	_____
3. Miscellaneous Property in Sec.	S _____ T _____ R _____	_____
	S _____ T _____ R _____	_____
4. Lot No. _____, Recorded Plat _____		
5. Private Claims _____		

STATE OF MICHIGAN  
CALHOUN COUNTY  
RECORDED

4 DEC 95 2:22 P.M.

ANNE B. NORLANDER  
CLERK - REGISTER OF DEEDS

Register of Deeds Stamp & File Number

I, William K. Crane, in a field survey on February 7, 19 95, do hereby certify that under requirements of P.A. 74, Michigan P.A. of 1970, the corner points mentioned in lines 1 and 2 above were in conformance with regulations and rules therefore as required in the current manual of survey instructions of the United States Department of the Interior, Bureau of Land Management or by a decree of a Court of Law and/or that the corner points mentioned in lines 3, 4 and 5 above were in conformance with the rules of the Michigan Board of Land Surveyors or by a Decree of a Court of Law; established, re-established, monumented, re-monumented, recovered, found as expressed below:

	A	B	C	D	E	F	G	H	I	J	K	L	M
2	6	5	4	3	2	1							
3													
4	7	8	9	10	11	12							
5													
6	18	17	16	15	14	13							
7													
8	19	20	21	22	23	24							
9													
10	30	29	28	27	26	25							
11													
12	31	32	33	34	35	36							
13													

**NOTE: Not more than 4 corners, all in the same town and range, may be recorded on this certificate.**

A. Description of original monument and accessories and/or subsequent restoration:

Original Survey 1825, Lucius Lyon:

16" W. Oak S 40.5° W 88 links  
12" Hickory N 52° W 148 links

B.F. Welles, April 12, 1880:

Found bottom of both witnesses and put in a marble 3 x 3, 18 inches long.  
20" Black Oak N 66°50' W 80 links

B. Description of corner evidence found and/or method applied in restoring or reestablishing corner:

Found 1/2" rerod fitting occupation. No other previous witnesses were left.  
Accepted as corner location.

CORNER  
REMONUMENTATION

FEB 22 1996

COMMISSION


LIBER 1834 PAGE 249

C. Description of monument for corner and accessories established to perpetuate locating the position of the corner:

Found 1/2" rerod, replaced with standard Calhoun County Remonumentation Corner (Harrison Monument)

12" Walnut N 10° E 133.85'  
10" Oak S 20° W 97.11'  
12" Maple N 80° W 70.70'  
Tel. Pedestal S 80° E 132.30'

This is accepted as the best available evidence of the position of the original corner.

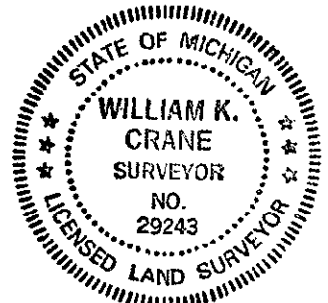

Signed by William K. Crane  
Surveyor's Michigan License No. 29243

Date November 20, 1995