

SURVEY &
REMONUMENTATION

RECORDED

1993

CALHOUN COUNTY REMONUMENTATION

COMMISSION

LAND CORNER RECORDATION CERTIFICATE
Filing Requirement of Act 74, Mich. P.A. 1970

NOV 19 1 01 PM 93

For corners in
Calhoun County
(County)

Located In: Corner Code #

CLERK REGISTER
CALHOUN COUNTY CLERK
ANNE D. WILSON

1. Public Land Survey	T 4 S R 4 W	A-1
	T 3 S R 4 W	A-13
	T 3 S R 5 W	M-13
	T 4 S R 5 W	M-1
2. Property Controlling in Section	S ___ T ___ R ___	___
	S ___ T ___ R ___	___
3. Miscellaneous Property in Sec.	S ___ T ___ R ___	___
	S ___ T ___ R ___	___

Register of Deeds Stamp & File Number

4. Lot No. _____, Recorded Plat _____
5. Private Claims _____

	A	B	C	D	E	F	G	H	I	J	K	L	M
2	6	5	4	3	2	1							
3													
4	7	8	9	10	11	12							
5													
6	18	17	16	15	14	13							
7													
8	19	20	21	22	23	24							
9													
10	30	29	28	27	26	25							
11													
12	31	32	33	34	35	36							
13													

I, Donald J. Davis, in a field survey on November 8, 19 93, do hereby certify that under requirements of P.A. 74, Michigan P.A. of 1970, the corner points mentioned in lines 1 and 2 above were in conformance with regulations and rules therefore as required in the current manual of survey instructions of the United States Department of the Interior, Bureau of Land Management or by a decree of a Court of Law and/or that the corner points mentioned in lines 3, 4 and 5 above were in conformance with the rules of the Michigan Board of Land Surveyors or by a Decree of a Court of Law; established, re-established, monumented, re-monumented, recovered, found as expressed below:

NOTE: Not more than 4 corners, all in the same town and range, may be recorded on this certificate.

A. Description of original monument and accessories and/or subsequent restoration:

Original corner found and replaced with iron bar and bricks. Found by A.H.Chase in 1939.
12" concrete post South 27.4'
6" T RR post North 27'
18" Maple N 35° W 30.2' (Gone)

B. Description of corner evidence found and/or method applied in restoring or reestablishing corner:

Found iron bar and bricks from witnesses.
Witnesses exist as
12" concrete post South 27.4'
6" T R.R. rail post North 27'


Accepted as good location of original corner, marked by local surveyors.

Corner Common to four townships.

LIBER 1716 PAGE 637

C. Description of monument for corner and accessories established to perpetuate locating the position of the corner:

Set Berntsen monument in monument box 4 feet North of centerline of "L" Drive, bricks around.
SE corner RR rail post North 27.08'
Top center round concrete post S 02° W 27.90'
Nail & tag 24" Burr Oak S 30° E 30.88'
Nail & tag 18" Maple N 63° W 57.60'

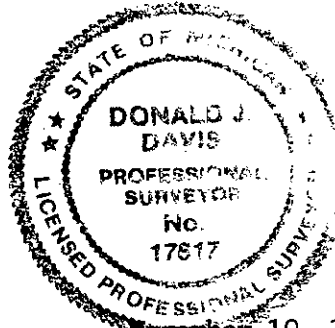

Signed by Donald J. Davis
Surveyor's Michigan License No. 17617

Date November 10, 1993