

APPROVED

Date 5-19-99 REC

CALHOUN COUNTY REMONUMENTATION  
LAND CORNER RECORDATION CERTIFICATE  
Filing Requirement of Act 74, Mich. P.A. 1970

STATE OF MICHIGAN  
CALHOUN COUNTY  
RECORDED

14 JUN 1999 1:57:25 PM

For corners in

<u>Calhoun</u> (County)	Located In:	Corner Code #
Fredonia Township		
1. Public Land Survey	T <u>3S</u> R <u>6W</u>	<u>I-10</u>
	T ___ R ___	_____
	T ___ R ___	_____
	T ___ R ___	_____
2. Property Controlling in Section	S ___ T ___ R ___	_____
	S ___ T ___ R ___	_____
3. Miscellaneous Property in Sec.	S ___ T ___ R ___	_____
	S ___ T ___ R ___	_____

ANNE B. NORLANDER  
CLERK - REGISTER OF DEEDS  
LIBER **2134** PAGE **497**

Register of Deeds Stamp & File Number

4. Lot No. \_\_\_\_\_, Recorded Plat \_\_\_\_\_  
5. Private Claims \_\_\_\_\_

I, William K. Crane, in a field survey on April 17, 1999 do hereby state that under requirements of P.A. 74, Michigan P.A. of 1970, the corner points mentioned in lines 1 and 2 above were in conformance with regulations and rules therefore as required in the current manual of survey instructions of the United States Department of the Interior, Bureau of Land Management or by a decree of a Court of Law and for that the corner points mentioned in lines 3, 4 and 5 above were in conformance with the rules of the Michigan Board of Land Surveyors or by a Decree of a Court of Law; established, re-established, monumented, recovered, found as expressed below:

NOTE: Not more than 2 corners, all in the same town and range, may be recorded on this certificate.

A	B	C	D	E	F	G	H	I	J	K	L	M
1												
2	6		5		4		3		2		1	
3												
4	7		8		9		10		11		12	
5												
6	18		17		16		15		14		13	
7												
8	19		20		21		22		23		24	
9												
10	30		29		28		27		26		25	
11												
12	31		32		33		34		35		36	
13												

A. Description of original monument and accessories and/or subsequent restoration:

G.L.O., Lucius Lyon, 1825:  
7" D.O. N 8° E 248 links  
6" Tamarack S 76° W 203 links

G. Lewis, 1882:  
Corner gone

C.D. Pike, 1972:  
Position established for survey by Dekeyser and Associates in 1973. Set iron at occupation.  
6" Oak N 25° E 21.85'  
5" Maple N 80° W 5.35'  
West side RR tie fence post with fence running East

B. Description of corner evidence found and/or method applied in restoring or reestablishing corner:


Found 1" pipe on West side of RR tie fence post. Placed Berntsen Monument over 1" pipe.

C. Description of monument for corner and accessories established to perpetuate locating the position of the corner:

Standard Calhoun County Remonumentation monument (Berntsen monument) and is accepted as the best available evidence of the position of the original corner.

- Set nail and tag in 8" Maple N 80° W 4.75'
- Set nail and tag in 8" Quad Maple S 70° E 18.05'
- Set nail and tag in 14" Maple N 05° E 61.50'
- Set nail and tag in 10" Maple N 30° W 39.20'

SURVEY &  
REMONUMENTATION  
MAR 13 2000  
SECTION

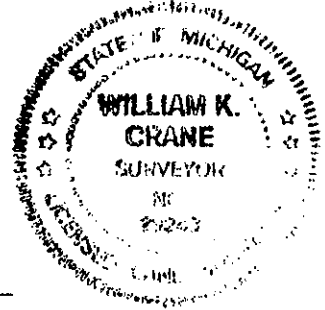

Signed by William K. Crane  
William K. Crane, P.S.

Date 5/19/99

Surveyor's Michigan License No. 29243