

MAR 30 1999

STATE OF MICHIGAN
CALHOUN COUNTY
RECORDED

20 JUL 1998 1:52:51 PM

ANNE B. NORLANDER
CLERK - REGISTER OF DEEDS

LIBER 2044 PAGE 151

Register of Deeds Stamp & File Number

APPROVED

Date 7-15-98 *urc*
CALHOUN COUNTY
REMONUMENTATION.

CALHOUN COUNTY REMONUMENTATION
LAND CORNER RECORDATION CERTIFICATE
Filing Requirement of Act 74, Mich. P.A. 1970

For corners in

Calhoun (County)	Located In:	Corner Code #
FREDONIA		
1. Public Land Survey	T <u>3S</u> R <u>6W</u>	<u>J-3</u>
	T ___ R ___	_____
	T ___ R ___	_____
	T ___ R ___	_____
2. Property Controlling in Section	S ___ T ___ R ___	_____
	S ___ T ___ R ___	_____
3. Miscellaneous Property in Sec.	S ___ T ___ R ___	_____
	S ___ T ___ R ___	_____

4. Lot No. _____, Recorded Plat _____
5. Private Claims _____

I, Michael A. Groat, in a field survey on September, 1997 do hereby state that under requirements of P.A. 74, Michigan P.A. of 1970, the corner points mentioned in lines 1 and 2 above were in conformance with regulations and rules therefore as required in the current manual of survey instructions of the United States Department of the Interior, Bureau of Land Management or by a decree of a Court of Law and for that the corner points mentioned in lines 3, 4 and 5 above were in conformance with the rules of the Michigan Board of Land Surveyors or by a Decree of a Court of Law; established, re-established, monumented, recovered, found as expressed below:

NOTE: Not more than 2 corners, all in the same town and range, may be recorded on this certificate.

A	B	C	D	E	F	G	H	I	J	K	L	M
1												
2	6	5	4	3	2	1						
3												
4	7	8	9	10	11	12						
5												
6	16	17	18	15	14	13						
7												
8	19	20	21	22	23	24						
9												
10	30	29	28	27	26	25						
11												
12	31	32	33	34	35	36						
13												


A. Description of original monument and accessories and/or subsequent restoration:

Original Survey by Lucius Lyon, Deputy Surveyor, 1825, set post 39.98 chains East of SW corner. W. Oak, 8", N 53 1/2° W, 23 LKS, B. Oak, 13" N 78° E, 18 LKS

Art Brintnall, P.S. # 28407, in L.C.R.C. recorded in L. 1430, P. 867, stated that the corner was a "X" in the top of a concrete fence post NNW 4.57', 30" Oak, West 91.8', South, 36" Oak, SE 29.63' Power Pole.

B. Description of corner evidence found and/or method applied in restoring or reestablishing corner:

This corner measures the following:

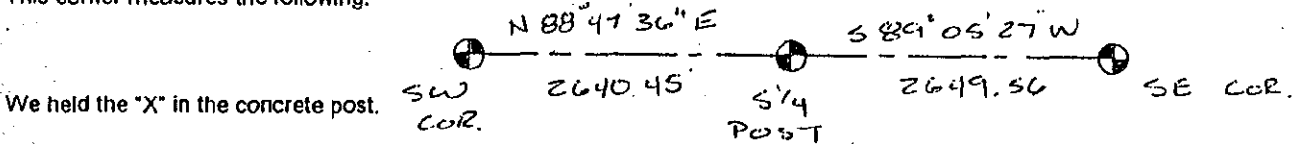


We held the "X" in the concrete post.

C. Description of monument for corner and accessories established to perpetuate locating the position of the corner:

- The corner is a chiseled "X" in the top of a 1' Dia. Concrete fence post. Carsonite marker north, 1'
- Nail & Tag in the E'ly side of a 30" Oak, 30° NAZ, 4.70'
- Nail & Tag in the W'ly side of a U.P., 148° NAZ, 29.40'
- Nail & Tag in the W'ly side of 6" tree, South, 50.60'
- Nail & Tag in the E'ly side of 30" Oak, North, 36.40'
- Nail & Tag in the N'ly side of 30" Oak, West, 92.70'

NAZ = Magnetic Azimuth measured from North

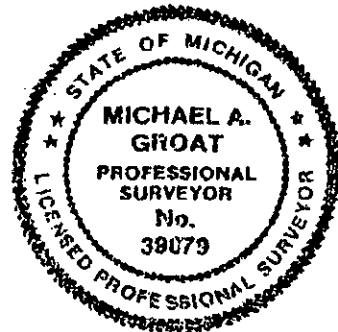

Signed by *Michael A. Groat*

Date May 21, 1998

Surveyor's Michigan License No. 39079