

MAR 13 2000

APPROVED

Date 10-20-99 RRL
CALHOUN COUNTY
REMONUMENTATION.

CALHOUN COUNTY REMONUMENTATION
LAND CORNER RECORDATION CERTIFICATE
Filing Requirement of Act 74, Mich. P.A. 1970

SECTION
STATE OF MICHIGAN
CALHOUN COUNTY
RECORDED

For corners in

| Calhoun (County) | Located In: | Cornor Code # |
|---------------------------------------|-------------------------------------|---------------|
| Fredonia Township | | |
| 1. Public Land Survey | T ___ R ___ | _____ |
| | T ___ R ___ | _____ |
| | T ___ R ___ | _____ |
| | T ___ R ___ | _____ |
| 2. Property Controlling in Section | S <u>26</u> T <u>3S</u> R <u>6W</u> | <u>J-10</u> |
| | S ___ T ___ R ___ | _____ |
| 3. Miscellaneous Property in Sec. | S ___ T ___ R ___ | _____ |
| | S ___ T ___ R ___ | _____ |

3 DEC 1999 2:37:52 PM

ANNE B. NORLANDER
CLERK - REGISTER OF DEEDS

LIBER 2182 PAGE 412

Register of Deeds Stamp & File Number

4. Lot No. _____, Recorded Plat _____
5. Private Claims _____

I, William K. Crane, in a field survey on October 15, 1999 do hereby state that under requirements of P.A. 74, Michigan P.A. of 1970, the corner points mentioned in lines 1 and 2 above were in conformance with regulations and rules therefore as required in the current manual of survey instructions of the United States Department of the Interior, Bureau of Land Management or by a decree of a Court of Law and /or that the corner points mentioned in lines 3, 4 and 5 above were in conformance with the rules of the Michigan Board of Land Surveyors or by a Decree of a Court of Law; established, re-established, monumented, recovered, found as expressed below:

NOTE: Not more than 2 corners, all in the same town and range, may be recorded on this certificate.

| | A | B | C | D | E | F | G | H | I | J | K | L | M |
|----|----|---|----|---|----|---|----|---|----|---|----|---|---|
| 1 | | | | | | | | | | | | | |
| 2 | 6 | | 5 | | 4 | | 3 | | 2 | | 1 | | |
| 3 | | | | | | | | | | | | | |
| 4 | 7 | | 8 | | 9 | | 10 | | 11 | | 12 | | |
| 5 | | | | | | | | | | | | | |
| 6 | 18 | | 17 | | 16 | | 15 | | 14 | | 13 | | |
| 7 | | | | | | | | | | | | | |
| 8 | 19 | | 20 | | 21 | | 22 | | 23 | | 24 | | |
| 9 | | | | | | | | | | | | | |
| 10 | 30 | | 29 | | 28 | | 27 | | 26 | | 25 | | |
| 11 | | | | | | | | | | | | | |
| 12 | 31 | | 32 | | 33 | | 34 | | 35 | | 36 | | |
| 13 | | | | | | | | | | | | | |

A. Description of original monument and accessories and/or subsequent restoration:

Center of Section 26: Point not set as part of original government survey.


B. Description of corner evidence found and/or method applied in restoring or reestablishing corner:

Intersected North and South 1/4 line with East and West 1/4 line. Set Berntsen monument.

C. Description of monument for corner and accessories established to perpetuate locating the position of the corner:

Set standard Calhoun County Remonumentation monument (Berntsen monument).

| | | |
|--------------------------------------|---------|---------|
| Nail & tag in 16" ash | South | 117.58' |
| Nail & tag in utility pole | S 60° E | 70.00' |
| Nail & tag in 38" hickory | S 85° E | 112.37' |
| Nail & tag in 12" red oak | S 85° W | 33.45' |
| 3' North of East and West fence line | | |

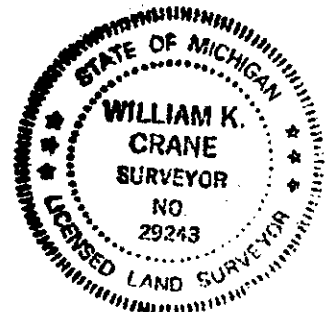

Signed by William K. Crane

Date October 25, 1999

William K. Crane, P.S.

Surveyor's Michigan License No. 29243