

# SURVEY & REMONUMENTATION

MAR 13 2000

## APPROVED

Date 5-19-99 KRC  
**CALHOUN COUNTY**  
**REMONUMENTATION.**

**SECTION**  
**CALHOUN COUNTY REMONUMENTATION**  
**LAND CORNER RECORDATION CERTIFICATE**  
 Filing Requirement of Act 74, Mich. P.A. 1970

STATE OF MICHIGAN  
 CALHOUN COUNTY  
 RECORDED

14 JUN 1999 1:57:03 PM

For corners in

<u>Calhoun</u>	Located In:	Corner Code #
(County)		
Fredonia Township		
1. Public Land Survey	T <u>3S</u> R <u>6W</u>	<u>J-11</u>
	T ___ R ___	_____
	T ___ R ___	_____
	T ___ R ___	_____
2. Property Controlling in Section	S ___ T ___ R ___	_____
	S ___ T ___ R ___	_____
3. Miscellaneous Property in Sec.	S ___ T ___ R ___	_____
	S ___ T ___ R ___	_____

AHNE B. NORLANDER  
 CLERK - REGISTER OF DEEDS  
 LIBER **2134** PAGE **495**

Register of Deeds Stamp & File Number

4. Lot No. \_\_\_\_\_, Recorded Plat \_\_\_\_\_  
 5. Private Claims \_\_\_\_\_

I, William K. Crane, in a field survey on April 16, 1999 do hereby state that under requirements of P.A. 74, Michigan P.A. of 1970, the corner points mentioned in lines 1 and 2 above were in conformance with regulations and rules therefore as required in the current manual of survey instructions of the United States Department of the Interior, Bureau of Land Management or by a decree of a Court of Law and for that the corner points mentioned in lines 3, 4 and 5 above were in conformance with the rules of the Michigan Board of Land Surveyors or by a Decree of a Court of Law; established, re-established, monumented, recovered, found as expressed below:

**NOTE: Not more than 2 corners, all in the same town and range, may be recorded on this certificate.**

A. Description of original monument and accessories and/or subsequent restoration:

G.L.O., Lucius Lyon, 1825:

18" B. Oak S 20° W 15 links  
 16" W. Oak N 3° W 27 links

L. W. Chase, 1948:

Iron stake with rocks  
 2' N of centerline gravel road  
 15" Apple S 30° W 51.2'  
 7" Tw. Hickory 39.3'  
 7" Oak N 65° W 108.5'

MSHD, Frank Holmes, 1963:

Found 3/4" pipe, raised with 1-1/2" pipe  
 T. Pole S 65° W 80.02'  
 30" Apple S 20° W 52.25'  
 Fence post S 34.13'

Fred Cutcher, 1995:

Found 1-1/2" iron pipe  
 12" W. Cherry S 04° E 40.1'  
 10" Apple N 50° W 45.5'  
 NE corner Section 35 E 2662.24'

B. Description of corner evidence found and/or method applied in restoring or reestablishing corner:

Found 1-1/2" pipe over 3/4" pipe with rocks. Replaced with Berntsen monument and monument box.

C. Description of monument for corner and accessories established to perpetuate locating the position of the corner:

Standard Calhoun County Remonumentation monument (Berntsen monument) with monument box and is accepted as the best available evidence of the position of the original corner.


Set nail and tag in 10" Apple	N 50° W	45.94'
Set nail and tag in 18" Twin Locust	N 75° W	152.30'
Set nail and tag in 8" Boxelder	S 25° W	48.47'
Set nail and tag in 10" tree	N 83° E	162.55'

Signed by William K. Crane

Date 5/19/99

William K. Crane, P.S.

Surveyor's Michigan License No. 29243

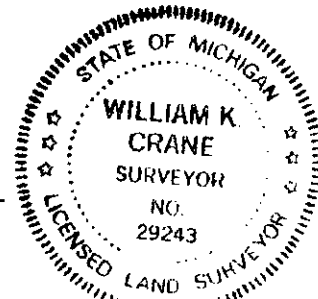

	A	B	C	D	E	F	G	H	I	J	K	L	M
1													
2		6		5		4		3		2		1	
3													
4		7		8		9		10		11		12	
5													
6		18		17		16		15		14		13	
7													
8		19		20		21		22		23		24	
9													
10		30		29		28		27		26		25	
11										●			
12		31		32		33		34		35		36	
13													