

**SURVEY &
REMONUMENTATION**

MAR 13 2000

APPROVED

STATE OF MICHIGAN
CALHOUN COUNTY
RECORDED

Date 5-19-99 RLL
**CALHOUN COUNTY
REMONUMENTATION.**
For corners in

SECTION
**CALHOUN COUNTY REMONUMENTATION
LAND CORNER RECORDATION CERTIFICATE**
Filing Requirement of Act 74, Mich. P.A. 1970

14 JUN 1999 1:56:52 PM

<u>Calhoun</u> (County)	Located In:	Corner Code #
Fredonia Township		
1. Public Land Survey	T <u>3S</u> R <u>6W</u>	<u>K-11</u>
	T _____ R _____	_____
	T _____ R _____	_____
	T _____ R _____	_____
2. Property Controlling in Section	S _____ T _____ R _____	_____
	S _____ T _____ R _____	_____
3. Miscellaneous Property in Sec.	S _____ T _____ R _____	_____
	S _____ T _____ R _____	_____
4. Lot No. _____, Recorded Plat _____		
5. Private Claims _____		

ANNE B. NORLANDER
CLERK - REGISTER OF DEEDS
LIBER **2134** PAGE **494**

Register of Deeds Stamp & File Number

I, William K. Crane, in a field survey on April 16, 1999 do hereby state that under requirements of P.A. 74, Michigan P.A. of 1970, the corner points mentioned in lines 1 and 2 above were in conformance with regulations and rules therefore as required in the current manual of survey instructions of the United States Department of the Interior, Bureau of Land Management or by a decree of a Court of Law and/or that the corner points mentioned in lines 3, 4 and 5 above were in conformance with the rules of the Michigan Board of Land Surveyors or by a Decree of a Court of Law, established, re-established, monumented, recovered, found as expressed below:

1	A	B	C	D	E	F	G	H	I	J	K	L	M
2		6		5		4		3		2		1	
3													
4		7		8		9		10		11		12	
5													
6		18		17		16		15		14		13	
7													
8		19		20		21		22		23		24	
9													
10		30		29		28		27		26		25	
11													
12		31		32		33		34		35		36	
13													

NOTE: Not more than 2 corners, all in the same town and range, may be recorded on this certificate.

A. Description of original monument and accessories and/or subsequent restoration:

G.L.O., Lucius Lyon, 1825:
14" Burr Oak S 73-1/2° W 89 links
8" B. Oak N 7-1/2° W 72 links

Courtright, 1903:
Iron stake and brick
8" Pin Oak S 44° W 78-3/4 links
10" Cherry N 60° W 80-7/8 links


Fred Cutcher, 1995:
Found 1/2" iron rod in monument box
Top center tel. pedestal N 60° W 57.82'
Top center tel. pedestal S 43° W 73.07'
Cen. util. pole S 81° E 46.8'
North 1/4 corner Section 35 W 2662.24'
S. edge conc. road N 11.85'

B. Description of corner evidence found and/or method applied in restoring or reestablishing corner:

Found iron in monument box. Replaced with Berntsen monument and reset monument box.

C. Description of monument for corner and accessories established to perpetuate locating the position of the corner:

Standard Calhoun County Remonumentation monument (Berntsen monument) with monument box and is accepted as the best available evidence of the position of the original corner.
Set nail and tag in 36" Maple S 20° E 86.43'
Set nail and tag in 18" Walnut S 73° W 89.70'
Set nail and tag in 8" Juniper N 80° W 91.34'
Set nail and tag in 14" Maple N 50° E 67.62'
0.5' East of centerline of Old 27

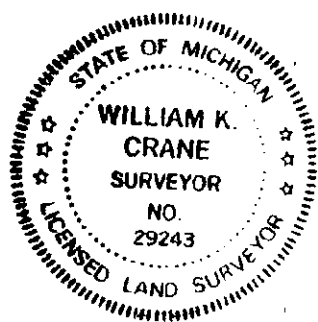

Signed by William K. Crane Date 5/19/99
William K. Crane, P.S.

Surveyor's Michigan License No. 29243