


CALHOUN COUNTY

REMONUMENTATION

NEWTON TOWNSHIP TOWN 3 SOUTH RANGE 7 WEST

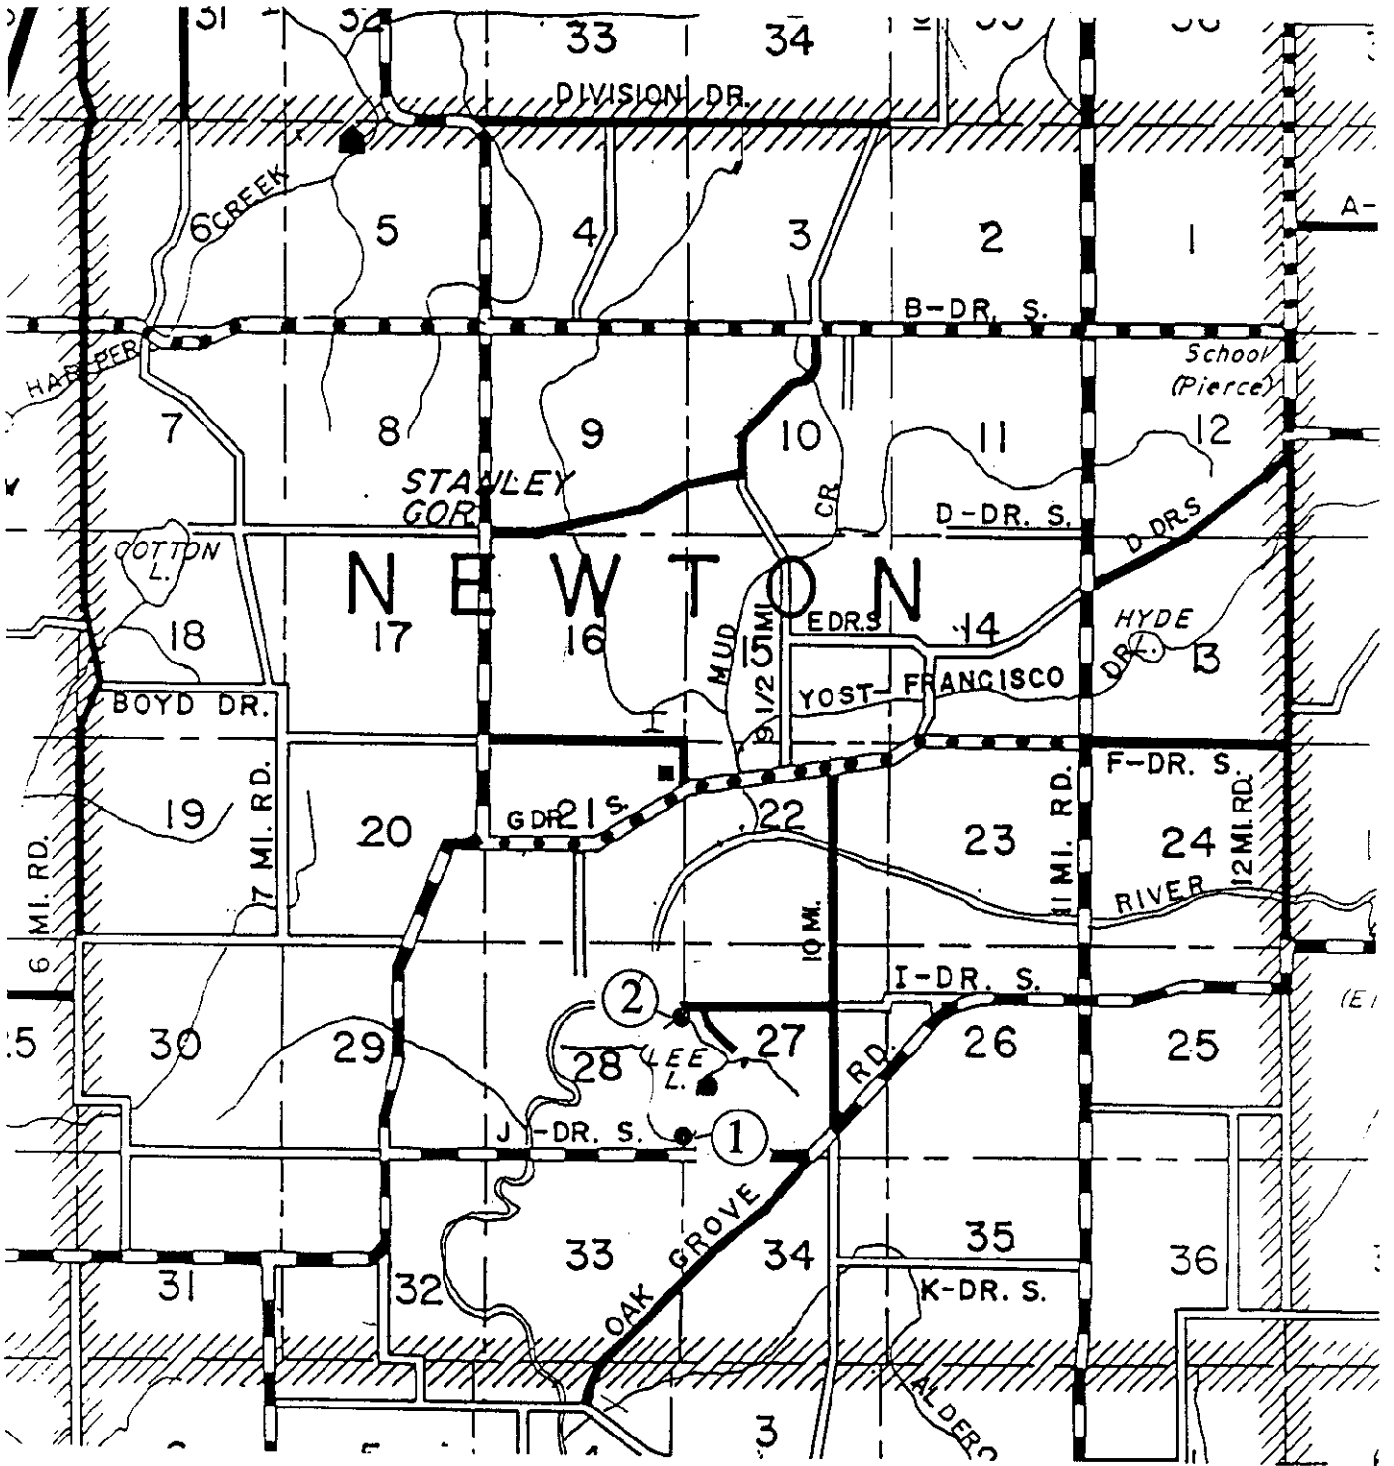

OTHER NO.

- 1 MEANDER CORNER LIBER 1781 PAGE 675
- 2 MEANDER CORNER LIBER 1781 PAGE 675

SURVEY &
REMONUMENTATION

MAY 05 1997

COMMISSION