

REMONUMENTATION

FEB 22 1996

APPROVED

Date Dec 6 1995

COMMISSION CALHOUN COUNTY REMONUMENTATION

STATE OF MICHIGAN CALHOUN COUNTY RECORDED

LAND CORNER RECORDATION CERTIFICATE

Filing Requirement of Act 74, Mich. P.A. 1970

12 DEC 95 10:59 A.M.

ANNE B. NORLANDER CLERK - REGISTER OF DEEDS

LIBER 1835 PAGE 418

Register of Deeds Stamp & File Number

For corners in Calhoun (County) Newton Twp.

	Located In:	Corner Code #
1. Public Land Survey	T 3 S R 7 W	A-2
	T R	
	T R	
	T R	
	T R	
2. Property Controlling in Section	S T R	
	S T R	
3. Miscellaneous Property in Sec.	S T R	
	S T R	
4. Lot No. _____, Recorded Plat _____		
5. Private Claims _____		

A	B	C	D	E	F	G	H	I	J	K	L	M
2	6	5	4	3	2	1						
3												
4	7	8	9	10	11	12						
5												
6	18	17	16	15	14	13						
7												
8	19	20	21	22	23	24						
9												
10	30	29	28	27	26	25						
11												
12	31	32	33	34	35	36						
13												


I, Donald J. Davis, in a field survey on October 3, 19 95, do hereby certify that under requirements of P.A. 74, Michigan P.A. of 1970, the corner points mentioned in lines 1 and 2 above were in conformance with regulations and rules therefore as required in the current manual of survey instructions of the United States Department of the Interior, Bureau of Land Management or by a decree of a Court of Law and/or that the corner points mentioned in lines 3, 4 and 5 above were in conformance with the rules of the Michigan Board of Land Surveyors or by a Decree of a Court of Law; established, re-established, monumented, re-monumented, recovered, found as expressed below:

**NOTE: Not more than 4 corners, all in the same town and range, may be recorded on this certificate.**

A. Description of original monument and accessories and/or subsequent restoration:  
 Original survey by Sibley in 1826. Corner was not set but location information was used to determine acreage of 1/4 section to North and South.  
 Resurvey of 1897 by Whitney. When done location was used to establish center of section and tile set in swamp.

B. Description of corner evidence found and/or method applied in restoring or reestablishing corner:  
 No evidence of corner found. Section was surveyed to establish location using areas to North and South which matched the original survey very close.  
 Corner was placed at proportional distance from E 1/4 Post of Section 1, T3S, R8W. This location matches occupation and areas of land controlled by the intended corner location.  
 Accepted this location as good position for theoretical corner.

C. Description of monument for corner and accessories established to perpetuate locating the position of the corner:  
 Set Berntsen monument in box in bituminous surface. Falls in West edge of paving.  
 14.85' North of East 1/4 Post, Section 1, T3S, R8W.  
 Nail & Tag 30" Oak S 45° E 42.17'  
 Nail & Tag 28" Hickory S 6° W 28.30'  
 Nail & Tag 34" Oak S 30° W 78.31'  
 Nail & Tag 24" Hickory S 40° E 63.40'

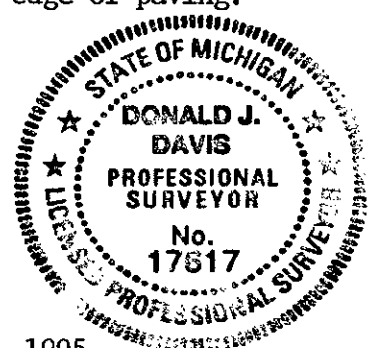

Signed by Donald J. Davis Date December 4, 1995  
 Surveyor's Michigan License No. 17617