

APPROVED

Date 11-12-96  
CALHOUN COUNTY  
REMONUMENTATION.

CALHOUN COUNTY REMONUMENTATION  
LAND CORNER RECORDATION CERTIFICATE  
Filing Requirement of Act 74, Mich. P.A. 1970

STATE OF MICHIGAN  
CALHOUN COUNTY  
RECORDED

19 FEB 97 3:49 P.M.

ANNE D. NORLANDER  
CLERK - REGISTER OF DEEDS

LIBER 1916 PAGE 109

Register of Deeds Stamp & File Number

For corners in

Calhoun (County)	Located In:	Corner Code #/
Newton Twp.		
1. Public Land Survey	T <u>3S</u> R <u>7W</u>	<u>E-5</u>
	T _____ R _____	_____
	T _____ R _____	_____
	T _____ R _____	_____
2. Property Controlling in Section	S _____ T _____ R _____	_____
	S _____ T _____ R _____	_____
3. Miscellaneous Property in Sec.	S _____ T _____ R _____	_____
	S _____ T _____ R _____	_____
4. Lot No. _____, Recorded Plat _____		
5. Private Claims _____		

I, Donald J. Davis, in a field survey on October 8, 1996, do hereby certify that under requirements of P.A. 74, Michigan P.A. of 1970, the corner points mentioned in lines 1 and 2 above were in conformance with regulations and rules therefore as required in the current manual of survey instructions of the United States Department of the Interior, Bureau of Land Management or by a decree of a Court of Law and/or that the corner points mentioned in lines 3, 4 and 5 above were in conformance with the rules of the Michigan Board of Land Surveyors or by a Decree of a Court of Law; established, re-established, monumented, re-monumented, recovered, found as expressed below:

NOTE: Not more than 4 corners, all in the same town and range, may be recorded on this certificate.

A. Description of original monument and accessories and/or subsequent restoration:


Original survey in 1826 by Sibley.  
Resurvey in 1897 by Whitney, tile set.  
Tile found and pipe set in concrete by Chase.

B. Description of corner evidence found and/or method applied in restoring or reestablishing corner:

Found pipe in concrete and pieces of tile.  
Accepted as good location of original corner location.

C. Description of monument for corner and accessories established to perpetuate locating the position of the corner:

Set Berntsen monument in monument box.  
3' East of centerline North and South.  
Nail & Tag 20" Maple S 20° E 94.45'  
Nail & Tag 20" Walnut S 15° W 79.00'  
Nail & Tag 44" Oak S 80° W 146.80'  
SE corner house foundation N 35° W 121.83'

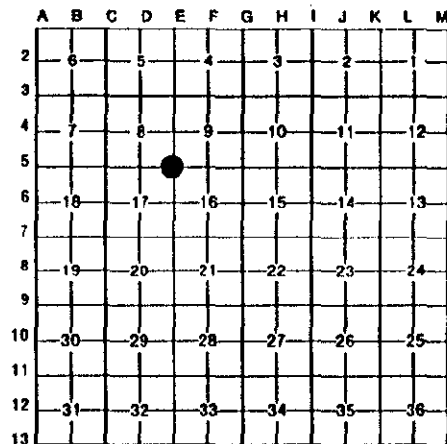

Newton Twp.

Signed by Donald J. Davis  
Surveyor's Michigan License No. 17617

Date 2/3/97

SURVEY &  
REMONUMENTATION



FORM APPROVED BY MICHIGAN STATE BOARD OF LAND SURVEYORS, JAN. 20, 1971  
REVISED MAY 14, 1975  
REVISED JAN., 1983

APR 07 1998

SECTION