

APPROVED
 Date 2-2-94
CALHOUN COUNTY
REMONUMENTATION.

CALHOUN COUNTY REMOUNTATION
LAND CORNER RECORDATION CERTIFICATE
 Filing Requirement of Act 74, Mich. P.A. 1970

For corners in
CALHOUN
 (County)

Located In: Corner Code #

1. Public Land Survey T 3 S R 7 W E-9
 T _____ R _____
 T _____ R _____
 T _____ R _____

2. Property Controlling S _____ T _____ R _____
 in Section S _____ T _____ R _____

3. Miscellaneous S _____ T _____ R _____
 Property in Sec. S _____ T _____ R _____

4. Lot No. _____, Recorded Plat _____

5. Private Claims _____

RECORDED
 FEB 4 3 12 PM '94
 CLERK-REGISTER
 CALHOUN COUNTY, MICH.
 ANN F. B. NORLANDER

Register of Deeds Stamp & File Number

	A	B	C	D	E	F	G	H	I	J	K	L	M
2	6	5	4	3	2	1							
3													
4	7	8	9	10	11	12							
5													
6	18	17	16	15	14	13							
7													
8	19	20	21	22	23	24							
9													
10	30	29	28	27	26	25							
11													
12	31	32	33	34	35	36							
13													

I, Michael A. Groat, in a field survey on Jan. 29, 19 94, do hereby certify that under requirements of P.A. 74, Michigan P.A. of 1970, the corner points mentioned in lines 1 and 2 above were in conformance with regulations and rules therefore as required in the current manual of survey instructions of the United States Department of the Interior, Bureau of Land Management or by a decree of a Court of Law and/or that the corner points mentioned in lines 3, 4 and 5 above were in conformance with the rules of the Michigan Board of Land Surveyors or by a Decree of a Court of Law; established, re-established, monumented, re-monumented, recovered, found as expressed below:

NOTE: Not more than 4 corners, all in the same town and range, may be recorded on this certificate.

A. Description of original monument and accessories and/or subsequent restoration:

- Re-Survey Pike 1968
- Found large stone, set Iron
- tile. East side fence post
- 10" Tamarac, N42 1/2° E, 35 lns Creek bank South 19'
- 8" Tamarac, S44° W 35 lns 4" Cherry, S80° W 8'
- 15" Black Oak, N10° E, 86.7'

B. Description of corner evidence found and/or method applied in restoring or reestablishing corner:

Found iron referenced by Pike in 1968, dug and found pieces of broken tile in rocks.


SURVEY & REMONUMENTATION
 OCT 27 1994
 COMMISSION

LIBER 1730 PAGE 835

C. Description of monument for corner and accessories established to perpetuate locating the position of the corner:

Set Berntsen monument in place of tile, stamped license #39079 in top of brass cap along with corner information.

- Witnesses:
- 12" Maple, North 17.8' (Nail with spotter)
 - 8" Maple, S87° E, 19' (Nail with spotter)
 - 12" Maple, S40° E, 14.3' (Nail with spotter)
 - 15" Walnut, West, 26.2' (Nail with spotter)

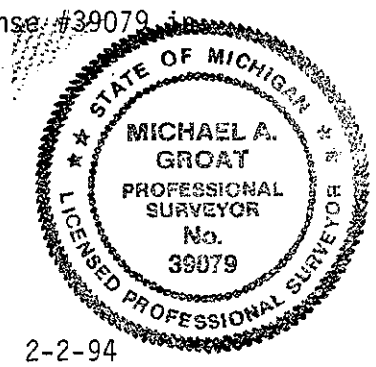

Signed by Michael A. Groat Date 2-2-94
 Surveyor's Michigan License No. 39079