

APPROVED

3-16-94
CALHOUN COUNTY
REMONUMENTATION

CALHOUN COUNTY REMONUMENTATION
LAND CORNER RECORDATION CERTIFICATE
Filing Requirement of Act 74, Mich. P.A. 1970

For corners in

CALHOUN COUNTY
(County)

Located In: NEWTON TWP Corner Code ##

- 1. Public Land Survey T 3 S R 7W E-11
- 2. Property Controlling S T R
- 3. Miscellaneous S T R
- Property in Sec. S T R

CLERK-REGISTER
CALHOUN COUNTY, MICH.
ANNE B. NORLANDER

APR 17 9 57 AM '94

RECORDED

Register of Deeds Stamp & File Number

4. Lot No. _____, Recorded Plat OCT 27 1994

5. Private Claims _____

COMMISSION

A	B	C	D	E	F	G	H	I	J	K	L	M
2	6	5	4	3	2							
3												
4	7	8	9	10	11	12						
5												
6	18	17	16	15	14	13						
7												
8	19	20	21	22	23	24						
9												
10	30	29	28	27	26	25						
11												
12	31	32	33	34	35	36						
13												

I, DANIEL M. RYAN, in a field survey on MARCH 5, 19 94, do hereby certify that under requirements of P.A. 74, Michigan P.A. of 1970, the corner points mentioned in lines 1 and 2 above were in conformance with regulations and rules therefore as required in the current manual of survey instructions of the United States Department of the Interior, Bureau of Land Management or by a decree of a Court of Law and/or that the corner points mentioned in lines 3, 4 and 5 above were in conformance with the rules of the Michigan Board of Land Surveyors or by a Decree of a Court of Law; established, re-established, monumented, re-monumented, recovered, found as expressed below:

NOTE: Not more than 4 corners, all in the same town and range, may be recorded on this certificate.

A. Description of original monument and accessories and/or subsequent restoration:

SOUTHEAST CORNER SECTION 29, T3S, R7W
GLO-Sylvester Sibley 1826
Set Post common to 28,29,32 & 33
B.Oak 10" S73°W 33 LKS
W.Oak 10" N59°E 48 LKS

RESURVEY -UNKNOWN
Fd SE corner from old witness tree and set post.
W.OAK 20" N59°E 48 LKS
ELM 5" N48½W 50 LKS

UNKNOWN REFERENCE TO TILE
FD Tile at SE Corner
Iron fence post N 33.8'
Wood fence post S 33.0'
Oak 15" S30°E 45.8'

B. Description of corner evidence found and/or method applied in restoring or reestablishing corner:

FOUND A P.K. NAIL ON PAVED ROAD; EXCAVATED TO A DEPTH OF 3.5 FEET AND FOUND A SMALL CLAY TILE INSIDE OF A LARGER DRAIN TILE WITH A DECAYING WOOD STAKE BESIDE IT. I ACCEPTED THIS AS THE TILE SET IN THE RESURVEY AND OTHER SURVEYS AS EVIDENCED BY THE WOOD STAKE.

LOCATION IS 1.7 FEET SOUTH OF THE EAST WEST ROAD AND APPROXIMATELY 6± FEET EAST OF A FENCE SOUTH


LIBER 1736 PAGE 775

C. Description of monument for corner and accessories established to perpetuate locating the position of the corner:

REMOVED TILES AND ANCIENT WOOD STAKE; SET STANDARD CALHOUN COUNTY MONUMENT WITH LICENSE #34975 STAMPED IN THE TOP AS WELL AS THE APPROPRIATE SECTIONS THIS IS COMMON TO.

WITNESSED AS FOLLOWS:

- 28" RED OAK N 4°E 45.86 feet SET 60P NAIL & WITNESS TAG IN WEST SIDE .
- 26" RED OAK N62°E 76.33 FEET SET 60P NAIL & WITNESS TAG IN SE SIDE.
- 16" MAPLE S56°E 67.40 FEET SET 60P NAIL & WITNESS TAG IN NORTH SIDE.
- 14" CHERRY S20°E 46.0 FEET SET 60P NAIL & WITNESS TAG IN EAST SIDE.
- 1.7 FEET SOUTH OF CENTERLINE OF EAST-WEST ROAD AND 6± FEET EAST OF FENCE SOUTH.

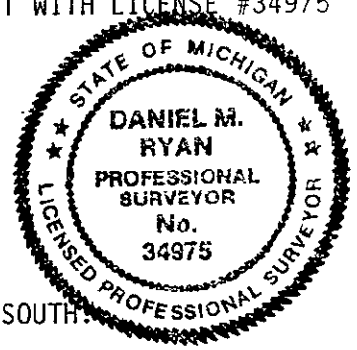

Signed by Daniel M. Ryan
Surveyor's Michigan License No. 34975

Date MARCH 16, 1994