

APPROVED

Date 2-2-94
**CALHOUN COUNTY
REMONUMENTATION.**

CALHOUN COUNTY REMOUNTATION
LAND CORNER RECORDATION CERTIFICATE
Filing Requirement of Act 74, Mich. P.A. 1970

For corners in

<u>CALHOUN</u> (County)	Located In:	Corner Code #
1. Public Land Survey	T <u>3s</u> R <u>7w</u>	<u>6-9</u>
	T _____ R _____	_____
	T _____ R _____	_____
	T _____ R _____	_____
2. Property Controlling in Section	S _____ T _____ R _____	_____
	S _____ T _____ R _____	_____
3. Miscellaneous Property in Sec.	S _____ T _____ R _____	_____
	S _____ T _____ R _____	_____

CLERK-REGISTERED
 CALHOUN COUNTY MICH
 ANNIE BLANCHARD
 FEB 4 3 12 PM 94
 RECORDED
 Register of Deeds Stamp & File Number

4. Lot No. _____, Recorded Plat _____

5. Private Claims _____

A	B	C	D	E	F	G	H	I	J	K	L	M
2	6	5	4	3	2	1						
3												
4	7	8	9	10	11	12						
5												
6	18	17	16	15	14	13						
7												
8	19	20	21	22	23	24						
9												
10	30	29	28	27	26	25						
11												
12	31	32	33	34	35	36						
13												

I, Michael A. Groat, in a field survey on 1/13/94, 19_____, do hereby certify that under requirements of P.A. 74, Michigan P.A. of 1970, the corner points mentioned in lines 1 and 2 above were in conformance with regulations and rules therefore as required in the current manual of survey instructions of the United States Department of the Interior, Bureau of Land Management or by a decree of a Court of Law and/or that the corner points mentioned in lines 3, 4 and 5 above were in conformance with the rules of the Michigan Board of Land Surveyors or by a Decree of a Court of Law; established, re-established, monumented, re-monumented, recovered, found as expressed below:

NOTE: Not more than 4 corners, all in the same town and range, may be recorded on this certificate.

A. Description of original monument and accessories and/or subsequent restoration:

ReSurvey	1952 L.W.C.
Tile	3/4" Iron stake
18" Tamarac N71°W 16 lks	6" Elm S85°W, 15.6'
	12" W.O. N30°W, 11.1'
	24" Elm East, 21.5'
	12" Poplar, South, 27.7'

B. Description of corner evidence found and/or method applied in restoring or reestablishing corner:

Found 3/4" Iron Stake and checked into 1952 witnesses:
 12" W.O. N30°W, 11.1' (stump remaining)
 12" Poplar, South, 27.7'

**SURVEY &
REMONUMENTATION**

OCT 27 1994


COMMISSION

LIBER 1730 PAGE 834

C. Description of monument for corner and accessories established to perpetuate locating the position of the corner:

Set standard Calhoun County Monument (Berntsen) with Brass cap and drill hole. Stamped license number 39079 in top along with corner info. Set 6' carsonite survey marker beside corner.

Witnesses:
 10" cherry N10°E, 12.5'
 8" cherry S10°E 8.65'
 10" Maple West, 48.2'
 10" Elm S70°W, 31.8'

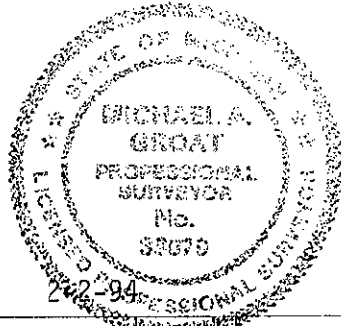

Signed by Michael A. Groat Date _____
 Surveyor's Michigan License No. 39079