

APPROVED

Date 2-2-73
CALHOUN COUNTY
REMONUMENTATION

CALHOUN COUNTY REMONUMENTATION
LAND CORNER RECORDATION CERTIFICATE
Filing Requirement of Act 74, Mich. P.A. 1970

CLERK-REGISTER
CALHOUN COUNTY, MICH.
ANN F. G. HORNBLANDER

FEB 4 3 12 PM 94

RECORDED

For corners in
CALHOUN
(County)

Located In: Corner Code #

1. Public Land Survey	T	3 S	R	7 W	H-9
	T		R		
	T		R		
	T		R		
2. Property Controlling in Section	S		T	R	
	S		T	R	
3. Miscellaneous Property in Sec.	S		T	R	
	S		T	R	

Register of Deeds Stamp & File Number

4. Lot No. _____, Recorded Plat _____
5. Private Claims _____

A	B	C	D	E	F	G	H	I	J	K	L	M
2	6	5	4	3	2	1						
3												
4	7	8	9	10	11	12						
5												
6	18	17	16	15	14	13						
7												
8	19	20	21	22	23	24						
9												
10	30	29	28	27	26	25						
11												
12	31	32	33	34	35	36						
13												

I, Michael A. Groat, in a field survey on January 29, 19 94, do hereby certify that under requirements of P.A. 74, Michigan P.A. of 1970, the corner points mentioned in lines 1 and 2 above were in conformance with regulations and rules therefore as required in the current manual of survey instructions of the United States Department of the Interior, Bureau of Land Management or by a decree of a Court of Law and/or that the corner points mentioned in lines 3, 4 and 5 above were in conformance with the rules of the Michigan Board of Land Surveyors or by a Decree of a Court of Law; established, re-established, monumented, re-monumented, recovered, found as expressed below:

NOTE: Not more than 4 corners, all in the same town and range, may be recorded on this certificate.

A. Description of original monument and accessories and/or subsequent restoration:

Re-Survey	1922 Comp.
Tile	Tile
5" Maple (No Bearing or dist.)	18" Maple, North 1 link
	24" B. Oak, S30°W 4 1/2 links
	18" B. Oak, S50°W, 23 1/4 links
	36" B. Oak, S30E 152 links

B. Description of corner evidence found and/or method applied in restoring or reestablishing corner:

Found 30" Maple at fence corner. Believe this is the tree referenced in 1922. Maple has grown around tile.
Found two witness irons set by J. Miller in 1992 20' south and west of corner.

SURVEY &
REMONUMENTATION

OCT 27 1994

COMMISSION


LIBER 1730 PAGE 840

C. Description of monument for corner and accessories established to perpetuate locating the position of the corner:

Set Berntsen monuments on section lines 10' South and West of corner. Stamped license # 39079 in top and placed carsonite markers by each.

Witnesses: 10' South of corner:
Nail and spotter in 12" Hickory, S3°W, 64.8'
Nail and spotter in 12" Oak, West 29.1'
Nail and spotter in 12" Maple, North 7.0'
Nail and spotter in 6" Cherry, South 23.0'

10' North of corner
Nail and spotter in 12" Maple, S10°E 2.3'
Nail and spotter in 12" Hickory, S50°W 66.7'
Nail and spotter in 12" Oak, S85°W 66.1'
Nail and spotter in 6" Cherry, S20°E 34.6'

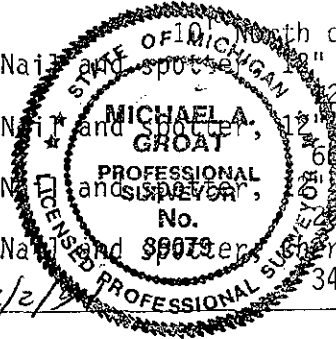

Signed by Michael A. Groat Date 2/2/94
Surveyor's Michigan License No. 39079