

APPROVED

Date 2-2-94
CALHOUN COUNTY
REMONUMENTATION

CALHOUN COUNTY REMOUNTATION
LAND CORNER RECORDATION CERTIFICATE
Filing Requirement of Act 74, Mich. P.A. 1970

For corners in
CALHOUN

(County)

Located In:

Corner Code #

1. Public Land Survey	T 3 S R 7 W	I-10
	T ___ R ___	_____
	T ___ R ___	_____
	T ___ R ___	_____
2. Property Controlling in Section	S ___ T ___ R ___	_____
	S ___ T ___ R ___	_____
3. Miscellaneous Property in Sec.	S ___ T ___ R ___	_____
	S ___ T ___ R ___	_____

CLERK-REGISTER
 CALHOUN COUNTY, MICH.
 ANNE D. NORLAND

FEB 4 3 12 PM '94

RECORDED

Register of Deeds Stamp & File Number

4. Lot No. _____, Recorded Plat _____
 5. Private Claims _____

A	B	C	D	E	F	G	H	I	J	K	L	M
2	6	5	4	3	2	1						
3												
4	7	8	9	10	11	12						
5												
6	18	17	16	15	14	13						
7												
8	19	20	21	22	23	24						
9												
10	30	29	28	27	26	25						
11												
12	31	32	33	34	35	36						
13												

I, Michael A. Groat, in a field survey on December, 19 93, do hereby certify that under requirements of P.A. 74, Michigan P.A. of 1970, the corner points mentioned in lines 1 and 2 above were in conformance with regulations and rules therefore as required in the current manual of survey instructions of the United States Department of the Interior, Bureau of Land Management or by a decree of a Court of Law and/or that the corner points mentioned in lines 3, 4 and 5 above were in conformance with the rules of the Michigan Board of Land Surveyors or by a Decree of a Court of Law; established, re-established, monumented, re-monumented, recovered, found as expressed below:

NOTE: Not more than 4 corners, all in the same town and range, may be recorded on this certificate.

A. Description of original monument and accessories and/or subsequent restoration:

Re-Survey	1991 J. Miller
Tile	Set iron mid-way on line between NE and SE corners of Section 27
24" Oak, N23 1/2°E, 32 lks	10" Cherry, S40°E, 5.31'
	10" Cherry, N43°E, 12.62'
	12" Cherry, N75°W, 10.34'
	8" Cherry, S40°W, 15.57'

B. Description of corner evidence found and/or method applied in restoring or reestablishing corner:

Found iron set by J. Miller, excavated 8'x8' area but found no evidence of tile. Old notes from Chase, 1922, referenced a corner 40.02 ch. (2641.32') from SE corner, distance between SE corner and NE corner measures 5283.01 and the split is 2641.51'.

Since the split measures 0.19' longer than what Chase measured in 1922, the Miller iron was held.

OCT 27 1994


COMMISSION

LIBER 1730 PAGE 839

C. Description of monument for corner and accessories established to perpetuate locating the position of the corner:

Set Berntsen monument with carsonite barker beside, stamped license #39079 and corner information in brass cap.

Witnesses:
 10" Cherry, S40°E, 5.31'
 10" Cherry, N43°E, 12.62'
 12" Cherry, N75°W, 10.34'
 8" Cherry, S40°W, 15.57'

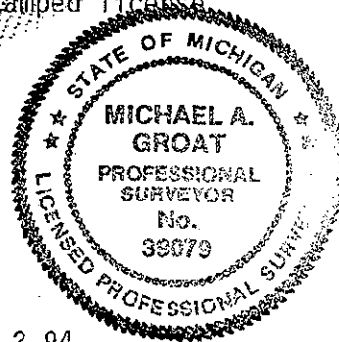

Signed by Michael A. Groat

Date 2-2-94

Surveyor's Michigan License No. 39079