

APPROVED

Date 12-16-97 RCL

CALHOUN COUNTY REMONUMENTATION.

CALHOUN COUNTY REMONUMENTATION LAND CORNER RECORDATION CERTIFICATE Filing Requirement of Act 74, Mich. P.A. 1970

STATE OF MICHIGAN
CALHOUN COUNTY
RECORDED

22 DEC 97 8:14 A.M.

ANNE B. NORLANDER
CLERK - REGISTER OF DEEDS

LIBER 1985 PAGE 606

Register of Deeds Stamp & File Number

For corners in

Calhoun (County)	Located in:	Corner Code #
Leroy Township		
1. Public Land Survey	T <u>3 S</u> R <u>8 W</u>	<u>A-7</u>
	T ___ R ___	_____
	T ___ R ___	_____
	T ___ R ___	_____
2. Property Controlling in Section	S ___ T ___ R ___	_____
	S ___ T ___ R ___	_____
3. Miscellaneous Property in Sec.	S ___ T ___ R ___	_____
	S ___ T ___ R ___	_____

4. Lot No. _____, Recorded Plat _____
5. Private Claims _____

I, William K. Crane, in a field survey on September 9, 1997 do hereby state that under requirements of P.A. 74, Michigan P.A. of 1970, the corner points mentioned in lines 1 and 2 above were in conformance with regulations and rules therefore as required in the current manual of survey instructions of the United States Department of the Interior, Bureau of Land Management or by a decree of a Court of Law and for that the corner points mentioned in lines 3, 4 and 5 above were in conformance with the rules of the Michigan Board of Land Surveyors or by a Decree of a Court of Law; established, re-established, monumented, recovered, found as expressed below:

NOTE: Not more than 2 corners, all in the same town and range, may be recorded on this certificate.

	A	B	C	D	E	F	G	H	I	J	K	L	M
1													
2	6		5		4		3		2		1		
3													
4	7		8		9		10		11		12		
5													
6	18		17		16		15		14		13		
7													
8	19		20		21		22		23		24		
9													
10	30		29		28		27		26		25		
11													
12	31		32		33		34		35		36		
13													

A. Description of original monument and accessories and/or subsequent restoration:

Original survey by Robert Clark, Jr., D.S. in 1826:

- 6" Beech S 67° E 23 links
- 6" Birch N 18° E 5½ links

Resurvey 1884 by F. Hodgman: Set post 22 links South from the corners of Section 13 and 24 Climax.

Witness card by A.H. Chase dated 1939:

Tile		
South face concrete fence post	North	30.9'
Climax Corner	North	15.1'
8" Elm	N 45° W	53.0'
24" Ash	S 20° W	25.7'
24" Ash	N 45° E	27.7'
14" Elm	S 70° E	74.5'


B. Description of corner evidence found and/or method applied in restoring or reestablishing corner:

Found clay tile 14.93 feet South of Climax Corner and one Chase witness remaining (concrete fence post)

C. Description of monument for corner and accessories established to perpetuate locating the position of the corner:

Placed 3-1/2" diameter steel sleeve 8-1/2" long over tile and left tile in place. Installed monument box in gravel road over sleeve and tile.

Set PK nail West side of utility pole	S 37° E	88.65'
Set nail North side of 6" Maple	S 85½° W	205.90'
Set nail South side of 8" Hickory	N 78¼° W	157.67'
Concrete anchor post	North	30.74'
Climax Corner	North	14.93'

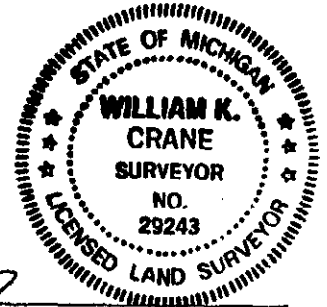

Signed by William K. Crane
William K. Crane, P.S.

Date 12/15/97

Surveyor's Michigan License No. 29243

SURVEY & REMONUMENTATION

FORM APPROVED BY MICHIGAN STATE BOARD OF PROFESSIONAL SURVEYORS, JAN. 28, 1971
REVISED MAY 14, 1973
REVISED JAN. 1983
REVISED OCT., 1986

APR 07 1998

SECTION