

APPROVED

Date 10-21-97

CALHOUN COUNTY REMONUMENTATION

For corners in

CALHOUN COUNTY REMONUMENTATION LAND CORNER RECORDATION CERTIFICATE Filing Requirement of Act 74, Mich. P.A. 1970

STATE OF MICHIGAN CALHOUN COUNTY RECORDED

24 OCT 97 12:01 P.M.

ANNE B. NORLANDER CLERK - REGISTER OF DEEDS

LIBER 1973 PAGE 180

Register of Deeds Stamp & File Number

Form with fields: CALHOUN (County), LEROY TOWNSHIP, 1. Public Land Survey, Located In: T 3S R 8W, Corner Code #: B-7

4. Lot No. _____, Recorded Plat _____
5. Private Claims _____

I, ROBERT R. CARR, in a field survey on OCTOBER 17, 1996 do hereby state that under requirements of P.A. 74, Michigan P.A. of 1970, the corner points mentioned in lines 1 and 2 above were in conformance with regulations and rules therefore as required in the current manual of survey instructions of the United States Department of the Interior, Bureau of Land Management or by a decree of a Court of Law and for that the corner points mentioned in lines 3, 4 and 5 above were in conformance with the rules of the Michigan Board of Land Surveyors or by a Decree of a Court of Law; established, re-established, monumented, recovered, found as expressed below:

NOTE: Not more than 2 corners, all in the same town and range, may be recorded on this certificate.

A. Description of original monument and accessories and/or subsequent restoration:

1826 G.L.O. GLARK
1885 RESURVEY BY HODGMAN FOUND STAKE WITH STONE AROUND
SET BY HIM IN PLACE OF ORIGINAL POST SOME YEARS BEFORE
SET POST (TILE) WITH STONE AROUND.
1939 WITNESSES TO TILE, NO NAME.
1971 DEKEYSER AND ASSOCIATES, 1/2" IRON NEXT TO TILE, 5 WITNESSES,


B. Description of corner evidence found and/or method applied in restoring or reestablishing corner:

FOUND TILE WITH 1/2" IRON ON WEST SIDE.
THREE DEKEYSER 1971 WITNESSES AND TWO 1939 WITNESSES REMAINING.
ACCEPTED AS TRUE PERPETUATION OF CORNER AND
REPLACED TILE WITH BERNTSEN MONUMENT IN MONUMENT BOX

C. Description of monument for corner and accessories established to perpetuate locating the position of the corner:

BERNTSEN MONUMENT IN MONUMENT BOX
SET SPOTTER IN 28" ASH, S28dW 56.61 FEET.
SET SPOTTER IN 8" OAK, S77dW 116.27 FEET.
SET SPOTTER IN 36" MAPLE, S25dE 83.23 FEET.
SOUTHWEST CORNER OF RAILROAD RAIL POST, N60dE 42.03 FEET (MEASURED FROM 1' ABOVE GROUND).

Grid table with columns A-M and rows 1-13. Cell (7, B) contains a circled '1'.

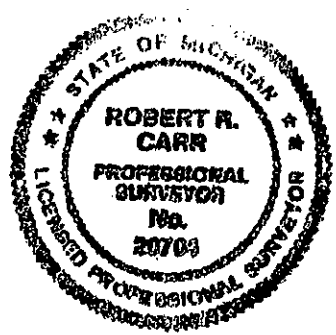

Signed by [Signature]
Surveyor's Michigan License No. 20704

Date October 20, 1997

SURVEY & REMONUMENTATION

FORM APPROVED BY MICHIGAN STATE BOARD OF PROFESSIONAL SURVEYORS, JAN. 28, 1971
REVISED MAY 14, 1975
REVISED JAN., 1983
REVISED OCT., 1995

APR 07 1998

SECTION