MAR 3 0 1999

SECTION

APPROVED
Date 12-9-98 RKC
CALHOUN COUNTY
REMONUMENTATION.

CALHOUN COUNTY REMONUMENTATION
LAND CORNER RECORDATION CERTIFICATE
Filing Requirement of Act 74, Mich. P.A. 1970

STATE OF MICHIGAN
CALHOUN COUNTY
RECORDED

15 DEC 1998 3:40:10 PM

ANNE D. NORLANDER
CLERK - REGISTER OF DEEDS

LIBER 2087 PAGE 941

Register of Deeds Stamp & File Number

For corners in CALHOUN (County)

		Located In:	Corner Code #
LEROY TOWNSHIP			
1. Public Land Survey		T 3S R 8W	F-9
		T____ R____	
		T____ R____	
		T____ R____	
2. Property Controlling	S____	T____ R____	
in Section	S____	T____ R____	
3. Miscellaneous	S____	T____ R____	
Property in Sec.	S____	T____ R____	

4. Lot No. _____ , Recorded Plat _____
5. Private Claims _____

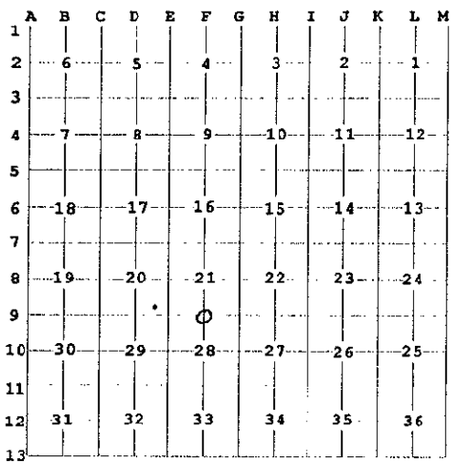

I, ROBERT R. CARR, in a field survey on JULY 16, 19 98 do hereby state that under requirements of P.A. 74, Michigan P.A. of 1970, the corner points mentioned in lines 1 and 2 above were in conformance with regulations and rules therefore as required in the current manual of survey instructions of the United States Department of the Interior, Bureau of Land Management or by a decree of a Court of Law and /or that the corner points mentioned in lines 3, 4 and 5 above were in conformance with the rules of the Michigan Board of Land Surveyors or by a Decree of a Court of Law; established, re-established, monumented, recovered, found as expressed below:

NOTE: Not more than 2 corners, all in the same town and range, may be recorded on this certificate.

1/4 POST COMMON TO SECTIONS 21 AND 28

A. Description of original monument and accessories and/or subsequent restoration:

ORIGINAL CORNER SET BY ROBERT CLARK, D.S. 1826

HODGMAN, 1885 RESURVEY, FOUND STAKE AT INTERSECTION OF ROAD LINES, NO WITNESS, SET POST (TILE) WITH STONE AROUND.

B. Description of corner evidence found and/or method applied in restoring or reestablishing corner:

FOUND 1/2" IRON AND PIECES OF BROKEN CONCRETE MONUMENT OVER RESURVEY TILE.

PLACED BERNSTEN MONUMENT OVER TILE IN MONUMENT BOX

C. Description of monument for corner and accessories established to perpetuate locating the position of the corner:

BERNSTEN MONUMENT OVER TILE IN MONUMENT BOX
U.S.G.S. BENCHMARK, S25°E 64.58 FEET
NORTH CORNER OF TRIANGULAR CONCRETE POST, S50°W 41.98 FEET
12" ASH, N45°W 52.72 FEET
IN CENTERLINE OF N&S ROAD
3'± NORTH OF CENTERLINE OF E&W ROAD

AND IS ACCEPTED AS A CAREFUL AND FAITHFUL PERPETUATION OF THE POSITION OF THE ORIGINAL CORNER.

STATE OF MICHIGAN
ROBERT R. CARR
PROFESSIONAL SURVEYOR
No. 20704
LICENSED PROFESSIONAL SURVEYOR

Signed by _____ Date DECEMBER 7, 1998

Surveyor's Michigan License No. 20704 ROBERT R. CARR

FORM APPROVED BY MICHIGAN STATE BOARD OF PROFESSIONAL SURVEYORS, JAN. 28, 1971
REVISED MAY 14,1975
REVISED JAN., 1983
REVISED OCT., 1995