

SURVEY & REMONUMENTATION

1993

CALHOUN COUNTY REMONUMENTATION

COMMISSION

LAND CORNER RECORDATION CERTIFICATE  
Filing Requirement of Act 74, Mich. P.A. 1970

RECORDED  
OCT 26 10 15 AM '93  
CLERK-REGISTER  
CALHOUN COUNTY, MICH.  
ANNE B. HOKI AIDER

For corners in

CALHOUN

(County)

Located in:

Corner Code #

- 1. Public Land Survey T 3 S R 8 W G-12  
T \_\_\_\_\_ R \_\_\_\_\_  
T \_\_\_\_\_ R \_\_\_\_\_  
T \_\_\_\_\_ R \_\_\_\_\_
- 2. Property Controlling S \_\_\_\_\_ T \_\_\_\_\_ R \_\_\_\_\_  
in Section S \_\_\_\_\_ T \_\_\_\_\_ R \_\_\_\_\_
- 3. Miscellaneous S \_\_\_\_\_ T \_\_\_\_\_ R \_\_\_\_\_  
Property in Sec. S \_\_\_\_\_ T \_\_\_\_\_ R \_\_\_\_\_

Register of Deeds Stamp & File Number

- 4. Lot No. \_\_\_\_\_, Recorded Plat \_\_\_\_\_
- 5. Private Claims \_\_\_\_\_

DONALD J. DAVIS in a field survey on OCTOBER 19, 19 93, do hereby certify that under requirements of P.A. 74, Michigan P.A. of 1970, the corner points mentioned in lines 1 and 2 above were in conformance with regulations and rules therefore as required in the current manual of survey instructions of the United States Department of the Interior, Bureau of Land Management or by a decree of a Court of Law and/or that the corner points mentioned in lines 3, 4 and 5 above were in conformance with the rules of the Michigan Board of Land Surveyors or by a Decree of a Court of Law; established, re-established, monumented, re-monumented, recovered, found as expressed below:

**NOTE: Not more than 4 corners, all in the same town and range, may be recorded on this certificate.**

	A	B	C	D	E	F	G	H	I	J	K	L	P
2	6	5	4	3	2	1							
3													
4	7	8	9	10	11	12							
5													
6	18	17	16	15	14	13							
7													
8	19	20	21	22	23	24							
9													
10	30	29	28	27	26	25							
11													
12	31	32	33	34	35	36							
13													

A. Description of original monument and accessories and/or subsequent restoration:

TILE SET IN 1884 RESURVEY BY HODGMAN AT INTERSECTION OF FENCES N & S AND CENTER OF ROAD.  
6" MAPLE S-E 66 LINKS.  
4" MAPLE N-E 67 LINKS.


B. Description of corner evidence found and/or method applied in restoring or reestablishing corner:

FOUND R.R. SPIKE AS RECORDED BY DEKEYSER IN 1972, LIBER 1007, PAGE 76.  
EXCAVATED 6' X 6' HOLE IN ROAD 3 FEET DEEP. FOUND NO EVIDENCE OF TILE OR CORNER.  
MAY HAVE BEEN DESTROYED BY ROAD CONSTRUCTION.  
ACCEPTED THE LOCATION OF THE R.R. SPIKE AS AN ACCEPTABLE REESTABLISHMENT OF THE CORNER.

C. Description of monument for corner and accessories established to perpetuate locating the position of the corner:

SET BERNISEN MONUMENT WITH BRASS CAP IN MONUMENT BOX AT CORNER LOCATION.  
FACE OF R.R. POST SOUTH 27.45'.  
NAIL & TAG 14" MAPLE NORTH 65.58'.  
NAIL & TAG 10" MAPLE N 40° W 42.65'.  
SW CORNER OF HOUSE FOUNDATION N 25° E 116.62'.  
NAIL & TAG TWIN 10" MAPLE N 60° E 74.60'.  
NAIL & TAG 32" MAPLE S 60° E 82.65'.

LIBER 1711 PAGE 092

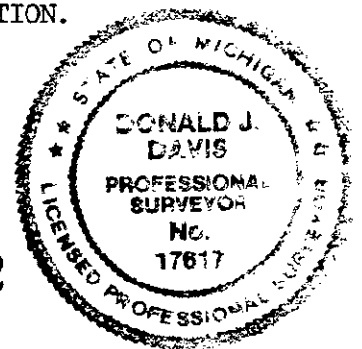

Signed by Donald J. Davis  
Surveyor's Michigan License No. 17617

Date OCTOBER 20, 1993