

SURVEY &  
REMONUMENTATION

1993

CALHOUN COUNTY REMONUMENTATION

COMMISSION

LAND CORNER RECORDATION CERTIFICATE  
Filing Requirement of Act 74, Mich. P.A. 1970

For corners in  
CALHOUN  
(County)

Located In:

Corner Code #

- |                                       |                           |             |
|---------------------------------------|---------------------------|-------------|
| 1. Public Land Survey                 | T <u>3</u> S R <u>8</u> W | <u>G-13</u> |
|                                       | T _____ R _____           | _____       |
|                                       | T _____ R _____           | _____       |
|                                       | T _____ R _____           | _____       |
| 2. Property Controlling<br>in Section | S _____ T _____ R _____   | _____       |
|                                       | S _____ T _____ R _____   | _____       |
| 3. Miscellaneous<br>Property in Sec.  | S _____ T _____ R _____   | _____       |
|                                       | S _____ T _____ R _____   | _____       |

CLFRK-REGISTER  
 CALHOUN COUNTY, MICH.  
 ANNE R. NORBLANDER

Oct 26 10 15 AM '93

RECORDED

Register of Deeds Stamp & File Number

4. Lot No. \_\_\_\_\_, Recorded Plat \_\_\_\_\_
5. Private Claims \_\_\_\_\_

I, DONALD J. DAVIS, in a field survey on SEPTEMBER 29, 1993, do hereby certify that under requirements of P.A. 74, Michigan P.A. of 1970, the corner points mentioned in lines 1 and 2 above were in conformance with regulations and rules therefore as required in the current manual of survey instructions of the United States Department of the Interior, Bureau of Land Management or by a decree of a Court of Law and/or that the corner points mentioned in lines 3, 4 and 5 above were in conformance with the rules of the Michigan Board of Land Surveyors or by a Decree of a Court of Law; established, re-established, monumented, re-monumented, recovered, found as expressed below:

**NOTE: Not more than 4 corners, all in the same town and range, may be recorded on this certificate.**

	A	B	C	D	E	F	G	H	I	J	K	L	M
2	6		5		4		3		2		1		
3													
4	7		8		9		10		11		12		
5													
6	18		17		16		15		14		13		
7													
8	19		20		21		22		23		24		
9													
10	30		29		28		27		26		25		
11													
12	31		32		33		34		35		36		
13													

A. Description of original monument and accessories and/or subsequent restoration:


TILE PLACED BY HODGMAN IN RESURVEY OF 1884.  
 18" ASH N 68° E 52 LINKS.  
 12" ELM N 20° E 29½ LINKS.  
 SET 67 LINKS EAST OF ATHENS CORNER.

B. Description of corner evidence found and/or method applied in restoring or reestablishing corner:

FOUND BROKEN SOLID TILE 6" UNDER SWAMP IN OLD FENCE LINE. FOUND HOLLOW TILE AT ATHENS CORNER 44.2 FEET WEST.  
 CORNERS ARE 44.2 FEET APART. OLD NOTES CALL FOR 67 LINKS (44.2 FEET).  
 BOTTOM SECTION IS GOOD.  
 ACCEPTED LEROY TILE AS TRUE CORNER.  
 LEROY CORNER IS IN WATER IN SWAMP AREA.

C. Description of monument for corner and accessories established to perpetuate locating the position of the corner:

SET BERNISEN MONUMENT WITH BRASS CAP OVER BOTTOM SECTION OF TILE.  
 NAIL & TAG 12" BURR OAK N 60° E 26.30'  
 NAIL & TAG 14" MAPLE N 10° E 22.63'  
 NAIL & TAG TWIN 12" BEECH S 15° E 53.75'  
 NAIL & TAG 24" ASH S 70° W 24.27'  
 NE'LY OF SMALL AREA OF HIGH GROUND.

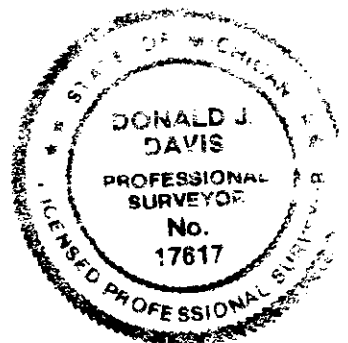

LIBER 1711 PAGE 085

Signed by Donald J. Davis  
 Surveyor's Michigan License No. 17617

Date OCTOBER 12, 1993