

**APPROVED**  
 Date 4-20-94  
**CALHOUN COUNTY**  
**REMONUMENTATION.**

CALHOUN COUNTY REMONUMENTATION  
**LAND CORNER RECORDATION CERTIFICATE**  
 Filing Requirement of Act 74, Mich. P.A. 1970

STATE OF MICHIGAN  
 CALHOUN COUNTY  
 RECORDED  
 25 APR 94 12:18 P.H.

ANNE B. NORLANDER  
 CLERK - REGISTER OF DEEDS

for corners in  
Calhoun  
 (County)

Located In: Corner Code #

Public Land Survey T 3 S R 8 W H-13  
 T \_\_\_ R \_\_\_  
 T \_\_\_ R \_\_\_  
 T \_\_\_ R \_\_\_

Property Controlling S \_\_\_ T \_\_\_ R \_\_\_  
 in Section S \_\_\_ T \_\_\_ R \_\_\_

Miscellaneous S \_\_\_ T \_\_\_ R \_\_\_  
 Property in Sec. S \_\_\_ T \_\_\_ R \_\_\_

Register of Deeds Stamp & File Number

Lot No. \_\_\_\_\_, Recorded Plat \_\_\_\_\_  
 Private Claims \_\_\_\_\_

	A	B	C	D	E	F	G	H	I	J	K	L	M
2	6	5	4	3	2	1							
3													
4	7	8	9	10	11	12							
5													
6	18	17	16	15	14	13							
7													
8	19	20	21	22	23	24							
9													
10	30	29	28	27	26	25							
11													
12	31	32	33	34	35	36							
13													

Donald J. Davis, in a field survey on April 9, 1994,  
 hereby certify that under requirements of P.A. 74, Michigan P.A. of 1970, the corner points mentioned  
 in lines 1 and 2 above were in conformance with regulations and rules therefore as required in the  
 current manual of survey instructions of the United States Department of the Interior, Bureau of Land  
 Management or by a decree of a Court of Law and/or that the corner points mentioned in lines 3, 4 and 5  
 above were in conformance with the rules of the Michigan Board of Land Surveyors or by a Decree of a  
 Court of Law, established, re-established, monumented, re-monumented, recovered, found as  
 expressed below:

**NOTE: Not more than 4 corners, all in the same town and range, may be recorded  
 on this certificate.**

Description of original monument and accessories and/or subsequent restoration:  
 Tile set in resurvey by Hodgeman in 1884 at base of tree with bricks.

**SURVEY &  
 REMONUMENTATION**


NOV 07 1994

**COMMISSION**

Description of corner evidence found and/or method applied in restoring or reestablishing corner:  
 Found bottom section of tile and bricks near old fence corner. All trees gone.  
 Accepted this as resurvey corner.

LIBER **1743** PAGE **583**

Description of monument for corner and accessories established to perpetuate locating the position of the corner:  
 Set Bernstein stainless monument with brass cap with stones around.  
 Nail & Tag 12" Red Oak S 80° W 17.10'  
 Nail & Tag Twin 10" Cherry S 30° E 33.80'  
 Nail & Tag 14" Red Oak S 45° E 25.70'  
 Nail & Tag 15" Maple S 50° E 53.60'  
 Nail & Tag 14" White Oak South 78.00'

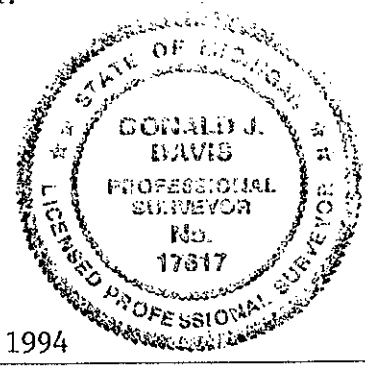

signed by Donald J. Davis Date April 20, 1994  
 Surveyor's Michigan License No. 17617