

SURVEY & REMONUMENTATION

1993

COMMISSION

CALHOUN COUNTY REMONUMENTATION

LAND CORNER RECORDATION CERTIFICATE
Filing Requirement of Act 74, Mich. P.A. 1970

CLERK-REGISTRAR
 CALHOUN COUNTY, MICH.
 ANNE R. HODGKINSON

OCT 26 10 15 AM '93

RECORDED

For corners in
CALHOUN
(County)

Located In:	Corner Code #
T 3 S R 8 W	I-11
T _____ R _____	_____
T _____ R _____	_____
T _____ R _____	_____
T _____ R _____	_____
S _____ T _____ R _____	_____
S _____ T _____ R _____	_____
S _____ T _____ R _____	_____
S _____ T _____ R _____	_____

Register of Deeds Stamp & File Number

4. Lot No. _____, Recorded Plat _____
5. Private Claims _____

	A	B	C	D	E	F	G	H	I	J	K	L	M
2	6		5		4		3		2		1		
3													
4	7		8		9		10		11		12		
5													
6	10		17		16		15		14		13		
7													
8	19		20		21		22		23		24		
9													
10	30		29		28		27		26		25		
11													
12	31		32		33		34		35		36		
13													

I, DONALD J. DAVIS, in a field survey on OCTOBER 19, 1993, do hereby certify that under requirements of P.A. 74, Michigan P.A. of 1970, the corner points mentioned in lines 1 and 2 above were in conformance with regulations and rules therefore as required in the current manual of survey instructions of the United States Department of the Interior, Bureau of Land Management or by a decree of a Court of Law and/or that the corner points mentioned in lines 3, 4 and 5 above were in conformance with the rules of the Michigan Board of Land Surveyors or by a Decree of a Court of Law; established, re-established, monumented, re-monumented, recovered, found as expressed below:

NOTE: Not more than 4 corners, all in the same town and range, may be recorded on this certificate.

A. Description of original monument and accessories and/or subsequent restoration:


TILE SET BY HODGMAN IN 1884 IN RESURVEY.
TILE FOUND AND RECORDED BY DEKEYSER IN 1975.
R.R. POST EAST 12.50'
12" OAK N 35° W 10.37'
16" CHERRY SOUTH 4.0'.

B. Description of corner evidence found and/or method applied in restoring or reestablishing corner:

FOUND TILE IN OLD RR GRADE FROM WITNESSES.
RR POST EAST 12.50'.
16" CHERRY SOUTH 4.0'.
ACCEPTED THIS CORNER AS RESTORATION OF ORIGINAL CORNER IN RESURVEY.

C. Description of monument for corner and accessories established to perpetuate locating the position of the corner:

SET BERNISEN MONUMENT WITH BRASS CAP OVER BOTTOM SECTION OF TILE. PLACED ROCKS AROUND.
NAIL & TAG 24" CHERRY SOUTH 3.00'.
NAIL & TAG RR TIE POST EAST 12.75'.
NAIL & TAG 24" RED OAK N 42° W 10.57'.
NAIL & TAG 14" HICKORY N 30° W 31.60'.
FENCE LINE RUNNING EAST.

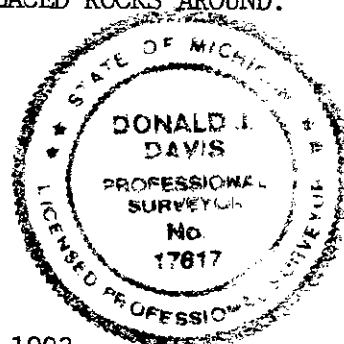

LIBER 1711 PAGE 090

Signed by Donald J. Davis

Date OCTOBER 20, 1993

Surveyor's Michigan License No. 17617