

CALHOUN COUNTY REMONUMENTATION

1993

LAND CORNER RECORDATION CERTIFICATE
Filing Requirement of Act 74, Mich. P.A. 1970

COMMISSION

For corners in
CALHOUN

(County)

Located in:

Corner Code #

- 1. Public Land Survey T 3 S R 8 W I-12
 T R
 T R
 T R
- 2. Property Controlling S T R
 in Section S T R
- 3. Miscellaneous S T R
 Property in Sec. S T R

- 4. Lot No. _____, Recorded Plat _____
- 5. Private Claims _____

CLERK-REGISTER
CALHOUN COUNTY, MICH.
ANNI B. HOKLANDER
Oct 26 10 15 AM '93

RECORDED

Register of Deeds Stamp & File Number

	A	B	C	D	E	F	G	H	I	J	K	L
2	6	5	4	3	2	1						
3												
4	7	8	9	10	11	12						
5												
6	18	17	16	15	14	13						
7												
8	19	20	21	22	23	24						
9												
10	30	29	28	27	26	25						
11												
12	31	32	33	34	35	36						
13												

I, DONALD J. DAVIS, in a field survey on OCTOBER 19, 1993, do hereby certify that under requirements of P.A. 74, Michigan P.A. of 1970, the corner points mentioned in lines 1 and 2 above were in conformance with regulations and rules therefore as required in the current manual of survey instructions of the United States Department of the Interior, Bureau of Land Management or by a decree of a Court of Law and/or that the corner points mentioned in lines 3, 4 and 5 above were in conformance with the rules of the Michigan Board of Land Surveyors or by a Decree of a Court of Law, established, re-established, monumented, re-monumented, recovered, found as expressed below:

NOTE: Not more than 4 corners, all in the same town and range, may be recorded on this certificate.


A. Description of original monument and accessories and/or subsequent restoration:
 TILE SET IN RESURVEY OF 1884 BY HODGMAN.
 12" ELM N 14° E 56 LINKS. (GONE)
 4" MAPLE N 56½° E 88½ LINKS. (GONE)
 TILE & PIPE FOUND IN 1952 BY L.W. CHASE.
 TILE AND WELD ROD IN MONUMENT BOX BY MDSH 1975 RECORDED IN LIBER 1075 PAGE 150.

B. Description of corner evidence found and/or method applied in restoring or reestablishing corner:
 FOUND TILE AND WELD ROD IN MONUMENT BOX AS CALLED FOR IN LIBER 1075, PAGE 150.

ACCEPTED THIS CORNER AS A GOOD PERPETUATION OF THE ORIGINAL CORNER.

C. Description of monument for corner and accessories established to perpetuate locating the position of the corner:

SET BERNISEN MONUMENT WITH BRASS CAP IN MONUMENT BOX.
 NAIL & TAG UTILITY POLE S 25° W 66.99'.
 MDSH TAG UTILITY POLE S 60° W 68.60'
 MDSH TAG UTILITY POLE N 70° W 82.95'.
 SW CORNER POST OFFICE N 30° E 43.32'.
 NAIL & TAG UTILITY POLE N 50° E 74.40'.

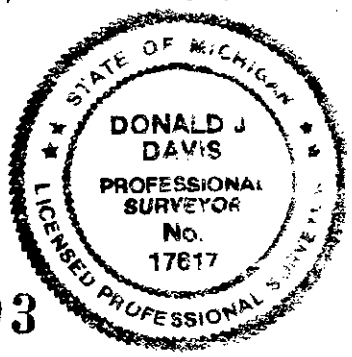

LIBER 1711 PAGE 093

Signed by Donald J. Davis Date OCTOBER 20, 1993

Surveyor's Michigan License No. 17617