

APPROVED

Date 4-20-94  
CALHOUN COUNTY  
REMONUMENTATION.

CALHOUN COUNTY REMONUMENTATION  
LAND CORNER RECORDATION CERTIFICATE  
Filing Requirement of Act 74, Mich. P.A. 1970

For corners in Calhoun (County)	Located In:	Corner Code #
1. Public Land Survey	T <u>3</u> S R <u>8</u> W	J-11
	T _____ R _____	_____
	T _____ R _____	_____
	T _____ R _____	_____
2. Property Controlling in Section	S _____ T _____ R _____	_____
	S _____ T _____ R _____	_____
3. Miscellaneous Property in Sec.	S _____ T _____ R _____	_____
	S _____ T _____ R _____	_____

STATE OF MICHIGAN  
CALHOUN COUNTY  
RECORDED

25 APR 94 12:18 P.M.

ANNE B. NORLANDER  
CLERK - REGISTER OF DEEDS

Register of Deeds Stamp & File Number

4. Lot No. \_\_\_\_\_, Recorded Plat \_\_\_\_\_  
5. Private Claims \_\_\_\_\_

	A	B	C	D	E	F	G	H	I	J	K	L	M
2	6		5		4		3		2		1		
3													
4	7		8		9		10		11		12		
5													
6	18		17		16		15		14		13		
7													
8	19		20		21		22		23		24		
9													
10	30		29		28		27		26		25		
11													
12	31		32		33		34		35		36		
13													

Donald J. Davis, in a field survey on April 19, 19 94,  
to hereby certify that under requirements of P.A. 74, Michigan P.A. of 1970, the corner points mentioned  
in lines 1 and 2 above were in conformance with regulations and rules therefore as required in the  
current manual of survey instructions of the United States Department of the Interior, Bureau of Land  
Management or by a decree of a Court of Law and/or that the corner points mentioned in lines 3, 4 and 5  
above were in conformance with the rules of the Michigan Board of Land Surveyors or by a Decree of a  
Court of Law; established, re-established, monumented, re-monumented, recovered, found as  
expressed below:

NOTE: Not more than 4 corners, all in the same town and range, may be recorded  
on this certificate.

6. Description of original monument and accessories and/or subsequent restoration:

Resurvey in 1884 by Hodgeman.	1975, Phil Mc Pherson
Found original stake & bearing tree	Iron
Set tile	12" Oak S 86° E 83.41'
6" White Oak S 68° E 170½ links	Anchor Post S 85° W 40.25'
	4' North of fence West.
	12.7' West of centerline pavement.

7. Description of corner evidence found and/or method applied in restoring or reestablishing corner:

Found ½" iron, checked to 1975 witnesses.  
Used in local surveys by DeKeyser.  
Original corner destroyed by road construction.  
Accepted as a true perpetuation of original corner.

SURVEY &  
REMONUMENTATION

NOV 07 1994

COMMISSION


LIBER 1743 PAGE 585

8. Description of monument for corner and accessories established to perpetuate locating the position of the corner:

Set Bernsten monument in monument box.

Witnesses:

Nail & Spotter utility pole S 50° W 85.90'  
Nail & Spotter 6" pine N 80° W 38.60'  
Nail & Spotter 20" Cherry N 20° W 114.30'  
Nail & Spotter 20" Oak S 86° E 83.40'

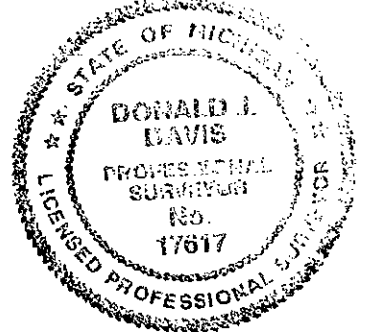

Signed by Donald J. Davis

Date April 19, 1994

Surveyor's Michigan License No. 17617