

# APPROVED

Date 4-20-94  
**CALHOUN COUNTY  
REMONUMENTATION.**

CALHOUN COUNTY REMONUMENTATION  
**LAND CORNER RECORDATION CERTIFICATE**  
Filing Requirement of Act 74, Mich. P.A. 1970

STATE OF MICHIGAN  
CALHOUN COUNTY  
RECORDED

For corners in

Calhoun (County)	Located In:	Corner Code #/
Public Land Survey	T <u>3S</u> R <u>8W</u>	<u>J-13</u>
	T _____ R _____	_____
	T _____ R _____	_____
	T _____ R _____	_____
Property Controlling in Section	S _____ T _____ R _____	_____
	S _____ T _____ R _____	_____
Miscellaneous Property in Sec.	S _____ T _____ R _____	_____
	S _____ T _____ R _____	_____

25 APR 94 12:18 P.M.  
ANNE B. NORLANDER  
CLERK - REGISTER OF DEEDS

Register of Deeds Stamp & File Number

Lot No. \_\_\_\_\_, Recorded Plat \_\_\_\_\_  
Private Claims \_\_\_\_\_

A	B	C	D	E	F	G	H	I	J	K	L	M
2	6	5	4	3	2	1						
3												
4	7	8	9	10	11	12						
5												
6	18	17	16	15	14	13						
7												
8	19	20	21	22	23	24						
9												
10	30	29	28	27	26	25						
11												
12	31	32	33	34	35	36						
13												

Donald J. Davis, in a field survey on April 16, 1994,  
I hereby certify that under requirements of P.A. 74, Michigan P.A. of 1970, the corner points mentioned  
in lines 1 and 2 above were in conformance with regulations and rules therefore as required in the  
current manual of survey instructions of the United States Department of the Interior, Bureau of Land  
Management or by a decree of a Court of Law and/or that the corner points mentioned in lines 3, 4 and 5  
above were in conformance with the rules of the Michigan Board of Land Surveyors or by a Decree of a  
Court of Law; established, re-established, monumented, re-monumented, recovered, found as  
expressed below:

NOTE: Not more than 4 corners, all in the same town and range, may be recorded  
on this certificate.

Description of original monument and accessories and/or subsequent restoration:

- Resurvey 1884 by Hodgeman. Found stake and stone, set tile.
- 10" Yellow Oak N 46° E 72½ links.
- 8 " Yellow Oak N 3° W 45½ links.
- G. Anderson, 1975. Found tile in monument box.
- 12" Triple Elm N 38° W 45.3'
- Steel & concrete corner post N 84° W 55.5'
- 12" Twin Wild Cherry N 85° W 54.26'
- 16.4 ' West of west edge of pavement
- Recorded in Liber 1875, pg. 148.

Description of corner evidence found and/or method applied in restoring or reestablishing corner:

- Found clay tile in monument box.
- Accepted as original corner.

**SURVEY &  
REMONUMENTATION**  
NOV 07 1994  
COMMISSION


LIBER 1743 PAGE 587

Description of monument for corner and accessories established to perpetuate locating the position of the corner:

- Set Bernsten monument in monument box.

Witnesses

- Concrete project marker S 75° E 106.43'
- Nail & Spotter Twin 12" Cherry West 54.15'
- Nail & Spotter Utility pole N 63° E 149.86'
- Nail & Spotter 6" Hickory N 60° W 37.61'
- Nail & Spotter 16.5' West of west edge of pavement.
- Athens corner West 34.35'

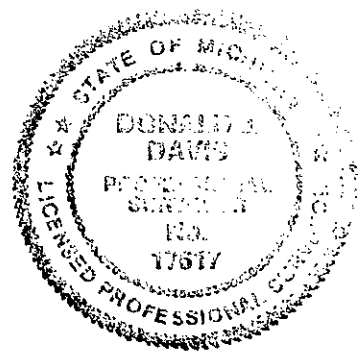

signed by Donald J. Davis Date April 19, 1994  
Surveyor's Michigan License No. 17617