

**SURVEY &
REMONUMENTATION**

1993

CALHOUN COUNTY REMONUMENTATION

COMMISSION

LAND CORNER RECORDATION CERTIFICATE
Filing Requirement of Act 74, Mich. P.A. 1970

For corners in

<u>CALHOUN</u> <small>(County)</small>	Located In:	Corner Code #
1. Public Land Survey	T <u>3</u> S R <u>8</u> W	<u>K-12</u>
	T _____ R _____	_____
	T _____ R _____	_____
	T _____ R _____	_____
2. Property Controlling in Section	S _____ T _____ R _____	_____
	S _____ T _____ R _____	_____
3. Miscellaneous Property in Sec.	S _____ T _____ R _____	_____
	S _____ T _____ R _____	_____
4. Lot No. _____, Recorded Plat _____		
5. Private Claims _____		

CLERK-REGISTER
CALHOUN COUNTY, MICH.
ANN F. B. NORLANDER

OCT 26 10 15 AM '93

RECORDED

Register of Deeds Stamp & File Number

I, DONALD J. DAVIS, in a field survey on SEPTEMBER 28, 19 93, do hereby certify that under requirements of P.A. 74, Michigan P.A. of 1970, the corner points mentioned in lines 1 and 2 above were in conformance with regulations and rules therefore as required in the current manual of survey instructions of the United States Department of the Interior, Bureau of Land Management or by a decree of a Court of Law and/or that the corner points mentioned in lines 3, 4 and 5 above were in conformance with the rules of the Michigan Board of Land Surveyors or by a Decree of a Court of Law; established, re-established, monumented, re-monumented, recovered, found as expressed below:

NOTE: Not more than 4 corners, all in the same town and range, may be recorded on this certificate.

A	B	C	D	E	F	G	H	I	J	K	L
2	6	5	4	3	2	1					
3											
4	7	8	9	10	11	12					
5											
6	18	17	16	15	14	13					
7											
8	19	20	21	22	23	24					
9											
10	30	29	28	27	26	25					
11											
12	31	32	33	34	35	36					
13											

A. Description of original monument and accessories and/or subsequent restoration:


TILE SET IN 1884 BY HODGMAN.
12" MAPLE N 40° W 72.25'.
12" MAPLE N 60° W 78.5'.
NW CORNER OF SCHOOL S 55° E 90.5'.
3/4" PIPE OVER TILE L.W. CHASE 1952.

B. Description of corner evidence found and/or method applied in restoring or reestablishing corner:

FOUND 3/4" PIPE OVER TILE WITH ROCKS AROUND.
3' SOUTH OF E & W CENTERLINE.
3' EAST OF N & S CENTERLINE.
ACCEPTED THIS AS ORIGINAL CORNER.

C. Description of monument for corner and accessories established to perpetuate locating the position of the corner:

SET BERNISEN MONUMENT WITH BRASS CAP IN MONUMENT BOX.
NAIL & TAG 20" MAPLE N 20° W 96.16'.
NAIL & TAG 24" MAPLE N 20° E 72.73'.
NAIL & TAG UTILITY POLE S 75° W 102.47'.
32" OAK S 15° E 121.52'.
NW CORNER BUILDING FOUNDATION S 45° E 90.5'.

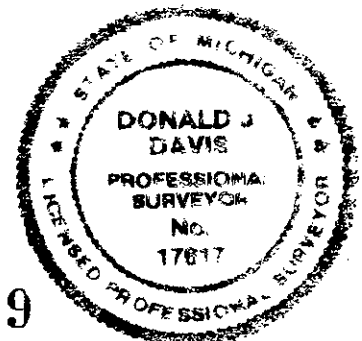

LIBER **1711** PAGE **089**

Signed by Donald J. Davis Date OCTOBER 13, 1993

Surveyor's Michigan License No. 17617