

1993

COMMISSION

LAND CORNER RECORDATION CERTIFICATE
Filing Requirement of Act 74, Mich. P.A. 1970

For corners in

Form with fields for County (CALHOUN), Located In (T 3 S R 8 W), Corner Code (# K-13), and numbered sections 1-5 for describing the survey and claims.

CLERK-REGISTER
CALHOUN COUNTY, MICH.
ANNE R. HOGG, CLERK

5:12 PM 10 15 AM 93

RECORDED

Register of Deeds Stamp & File Number

DONALD J. DAVIS in a field survey on SEPTEMBER 28, 1993 do hereby certify that under requirements of P.A. 74, Michigan P.A. of 1970, the corner points mentioned in lines 1 and 2 above were in conformance with regulations and rules therefore as required in the current manual of survey instructions of the United States Department of the Interior, Bureau of Land Management or by a decree of a Court of Law and/or that the corner points mentioned in lines 3, 4 and 5 above were in conformance with the rules of the Michigan Board of Land Surveyors or by a Decree of a Court of Law; established, re-established, monumented, re-monumented, recovered, found as expressed below:

NOTE: Not more than 4 corners, all in the same town and range, may be recorded on this certificate.

Grid table with columns A-L and rows 1-13, containing numbers 1-36.

A. Description of original monument and accessories and/or subsequent restoration:

- TILE SET IN 1884 BY HODGMAN IN RESURVEY.
14" POPLAR S 02° E 39 1/2 LINKS.
8" MAPLE S 62° W 87 LINKS.
TILE IN MONUMENT BOX 1975 MDSH. GONE
UTILITY POLE N 34° E 79.12'.
UTILITY POLE S 77° E 33.73' GONE.
USBM S 70° E 17.33' GONE.


B. Description of corner evidence found and/or method applied in restoring or reestablishing corner:

- FOUND 3/4" PIPE WITH PIECES OF BRICK.
NEW DRIVE CONSTRUCTION TO EAST MAY HAVE DESTROYED BOX AND TILE.
ACCEPTED THIS AS REESTABLISHED CORNER AS 3 WITNESSES MATCH OLD.

C. Description of monument for corner and accessories established to perpetuate locating the position of the corner:

- SET HARRISON MONUMENT 9" UNDER GRAVEL.
NAIL & TAG UTILITY POLE N 20° E 79.33'.
NAIL & TAG UTILITY POLE N 35° W 101.99'.
SW CORNER OF HOUSE FOUNDATION N 75° E 85.40'.
NW CORNER OF PORCH SOUTH 75.46'.
NAIL & TAG 36" MAPLE S 70° W 56.57'.
FACE 3" STEEL POST IN CONCRETE EAST 36.72'.

LIBER 1711 PAGE

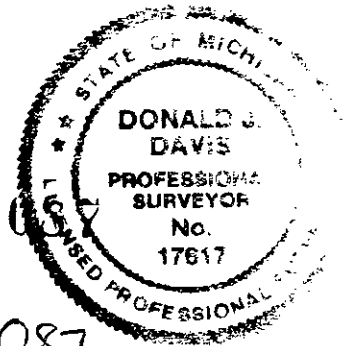

Signed by Donald J. Davis

Date OCTOBER 13, 1993

Surveyor's Michigan License No. 17617