APPROVED
Date Dec. 6 1995
CALHOUN COUNTY
REMONUMENTATION.

CALHOUN COUNTY REMONUMENTATION

LAND CORNER RECORDATION CERTIFICATE
Filing Requirement of Act 74, Mich. P.A. 1970

STATE OF MICHIGAN
CALHOUN COUNTY
RECORDED

12 DEC 95 10:59 A.M.

ANNE B. NORLANDER
CLERK - REGISTER OF DEEDS

LIBER 1835 PAGE 419

Register of Deeds Stamp & File Number

For corners in
Calhoun (County)
Leroy Twp.

		Located In:	Corner Code ##
1. Public Land Survey		T 3S R 8W	M-2
		T ___ R ___	
		T ___ R ___	
		T ___ R ___	
2. Property Controlling	S ___	T ___ R ___	
in Section	S ___	T ___ R ___	
3. Miscellaneous	S ___	T ___ R ___	
Property in Sec.	S ___	T ___ R ___	

4. Lot No. _____, Recorded Plat _____
5. Private Claims _____

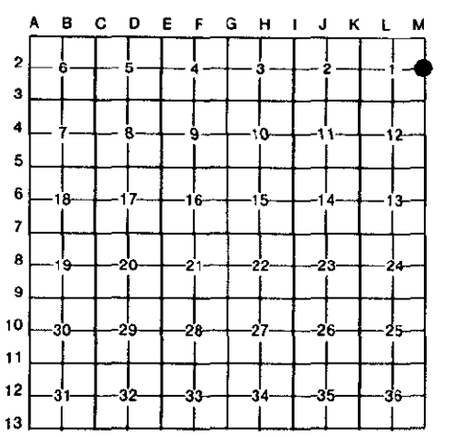

I, Donald J. Davis, in a field survey on October 3, 19 95, do hereby certify that under requirements of P.A. 74, Michigan P.A. of 1970, the corner points mentioned in lines 1 and 2 above were in conformance with regulations and rules therefore as required in the current manual of survey instructions of the United States Department of the Interior, Bureau of Land Management or by a decree of a Court of Law and/or that the corner points mentioned in lines 3, 4 and 5 above were in conformance with the rules of the Michigan Board of Land Surveyors or by a Decree of a Court of Law; established, re-established, monumented, re-monumented, recovered, found as expressed below:

NOTE: Not more than 4 corners, all in the same town and range, may be recorded on this certificate.

A. Description of original monument and accessories and/or subsequent restoration:

Original survey in 1826 by Clark.

Resurvey in 1885 by Hodgeman, tile set.

Corner found and used by DeKeyser in 1972, iron rod in monument box.

B. Description of corner evidence found and/or method applied in restoring or reestablishing corner:

Found iron in box as used for surveys of Section 1 of T3S, R8W and location of two pipelines crossing township line.

Accepted as good location and preservation of original corner.

CALHOUN COUNTY
REMONUMENTATION

FEB 2 2 1996

COMMISSION

C. Description of monument for corner and accessories established to perpetuate locating the position of the corner:

Set Berntsen monument in monument box. Corner falls 1 foot East of west edge of paving.

Nail & Cap 30" Oak S 80° E 35.40'
Nail & Cap 24" Hickory S 40° E 51.55'
Nail & Cap 28" Hickory S 45° W 17.65'
Nail & Cap 34" Oak S 20° W 63.72'

New subdivision in progress in Section 6, T3S, R8W, tied to corner.

STATE OF MICHIGAN
DONALD J. DAVIS
PROFESSIONAL SURVEYOR
No. 17617
LICENSED PROFESSIONAL SURVEYOR

Signed by Donald J. Davis Date December 4, 1995
Donald J. Davis
Surveyor's Michigan License No. 17617

FORM APPROVED BY MICHIGAN STATE BOARD OF LAND SURVEYORS, JAN. 28, 1971
REVISED MAY 14, 1975
REVISED JAN., 1983