

MAR 30 1999

APPROVED

Date 12-9-98 AKC
**CALHOUN COUNTY
REMONUMENTATION.**

**CALHOUN COUNTY REMONUMENTATION
LAND CORNER RECORDATION CERTIFICATE**
Filing Requirement of Act 74, Mich. P.A. 1970

STATE OF MICHIGAN
CALHOUN COUNTY
RECORDED

15 DEC 1998 3:38:39 PM

For corners in

CALHOUN
(County)

Located In:

Corner Code #

1. Public Land Survey		T <u>3S</u> R <u>8W</u>	<u>M-6</u>
		T _____ R _____	_____
		T _____ R _____	_____
		T _____ R _____	_____
2. Property Controlling in Section	S _____	T _____ R _____	_____
	S _____	T _____ R _____	_____
3. Miscellaneous Property in Sec.	S _____	T _____ R _____	_____
	S _____	T _____ R _____	_____

ANNE B. NDRLANDER
CLERK - REGISTER OF DEEDS
LIBER **2087** PAGE **938**

Register of Deeds Stamp & File Number

4. Lot No. _____, Recorded Plat _____
5. Private Claims _____

I, Michael A. Groat, in a field survey on November, 19 98 do hereby state that under requirements of P.A. 74, Michigan P.A. of 1970, the corner points mentioned in lines 1 and 2 above were in conformance with regulations and rules therefore as required in the current manual of survey instructions of the United States Department of the Interior, Bureau of Land Management or by a decree of a Court of Law and /or that the corner points mentioned in lines 3, 4 and 5 above were in conformance with the rules of the Michigan Board of Land Surveyors or by a Decree of a Court of Law; established, re-established, monumented, recovered, found as expressed below:


NOTE: Not more than 2 corners, all in the same town and range, may be recorded on this certificate.

	A	B	C	D	E	F	G	H	I	J	K	L	M
1													
2	6		5		4		3		2		1		
3													
4	7		8		9		10		11		12		
5													
6	18		17		16		15		14		13		
7													
8	19		20		21		22		23		24		
9													
10	30		29		28		27		26		25		
11													
12	31		32		33		34		35		36		
13													

A. Description of original monument and accessories and/or subsequent restoration:
 ORIGINAL SURVEY BY ROBERT CLARK, DEPUTY SURVEYOR, 1826, SET POST, W. OAK, 9", S 5° W, 54 LKS, W. OAK, 9", N 80 1/2° W, 12 LKS.
 1885, F. HODGEMAN, FOUND STAKE AND BEARING TREE, TAM, 6", S 15° E, 25 1/2 LKS, TAM, 10", S 85° E, 26 LKS.
 C. PIKE, P.S., 1974, TILE 14" MAPLE, EAST, 24.09'; 30" TRIPLE MAPLE, N 50° E, 17.76'; 5" MAPLE, N 40° W, 16.86'; 14" TWIN ASH, WEST, 14.45'

B. Description of corner evidence found and/or method applied in restoring or reestablishing corner:
 FOUND IRON IN TILE, 0.5' EAST OF FENCE RUNNING NORTH AND SOUTH. THIS IS IN A SWAMP WITH NO GOOD TREES AROUND ACCEPTED THE TILE AS A CAREFUL AND FAITHFUL PERPETUATION OF THE ORIGINAL CORNER.

C. Description of monument for corner and accessories established to perpetuate locating the position of the corner:
 SET BENRTSEN MONUMENT IN PLACE OF TILE.
 NAIL & TAG IN 16" ELM, S 18° E, 23.93'
 SE CORNER OF SECTION, (1/2" IRON) S 00° 28' 18" EAST, 2645.08'
 CENTER OF SECTION, (1/2" IRON) S 89° 34' 49" W, 2650.20'
 CARSONITE MARKER ON NORTH SIDE.

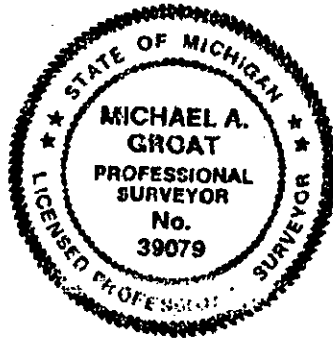

Signed by Michael A. Groat
Surveyor's Michigan License No. 39079

Date December 4, 1998