

1993

RECORDED

COMMISSION

CALHOUN COUNTY REMONUMENTATION

LAND CORNER RECORDATION CERTIFICATE
Filing Requirement of Act 74, Mich. P.A. 1970

Nov 19 1 01 PM 93

For corners in
Calhoun County
(County)

Located In: Corner Code #

- 1. Public Land Survey T 4 S R 4 W C-1
- T _____ R _____
- T _____ R _____
- T _____ R _____
- 2. Property Controlling S _____ T _____ R _____
- in Section S _____ T _____ R _____
- 3. Miscellaneous S _____ T _____ R _____
- Property in Sec. S _____ T _____ R _____

CLERK-REGISTER
CALHOUN COUNTY, MICH.
ANNE B. HORNBY

Register of Deeds Stamp & File Number

- 4. Lot No. _____, Recorded Plat _____
- 5. Private Claims _____

A	B	C	D	E	F	G	H	I	J	K	L	M
2	6	5	4	3	2	1						
3												
4	7	8	9	10	11	12						
5												
6	16	17	16	15	14	13						
7												
8	19	20	21	22	23	24						
9												
10	30	29	28	27	26	25						
11												
12	31	32	33	34	35	36						
13												

I, Donald J. Davis, in a field survey on November 8, 19 93, do hereby certify that under requirements of P.A. 74, Michigan P.A. of 1970, the corner points mentioned in lines 1 and 2 above were in conformance with regulations and rules therefore as required in the current manual of survey instructions of the United States Department of the Interior, Bureau of Land Management or by a decree of a Court of Law and/or that the corner points mentioned in lines 3, 4 and 5 above were in conformance with the rules of the Michigan Board of Land Surveyors or by a Decree of a Court of Law; established, re-established, monumented, re-monumented, recovered, found as expressed below:

NOTE: Not more than 4 corners, all in the same town and range, may be recorded on this certificate.

A. Description of original monument and accessories and/or subsequent restoration:

Original survey by Mullett 1825.

Sleigh shoe found by Dekeyser in 1973. Recorded in Liber 1027, page 69.

- 14" Butternut S 50° E 32.4'
- 28" Cherry S 45° E 68.2'
- 16" Hickory N 38° W 45.00'

B. Description of corner evidence found and/or method applied in restoring or reestablishing corner:

Found sleigh shoe in concrete in 6" tile from witnesses.

Corner has been used extensively in this area.


Accepted corner as location by usage and local preservation of original point.

LIBER 1716 PAGE 636

C. Description of monument for corner and accessories established to perpetuate locating the position of the corner:

Set Berntsen monument in monument box in centerline of L Drive 26 feet East of fence to north

- Center of sanitary M.H. S 07° W 20.6'
- NW corner of garage siding S 15° E 118.33'
- Center 14" Walnut N 78° E 71.0'
- P.K. nail in Power Pole S 41° W 59.52'
- 33.8' East of Albion corner.

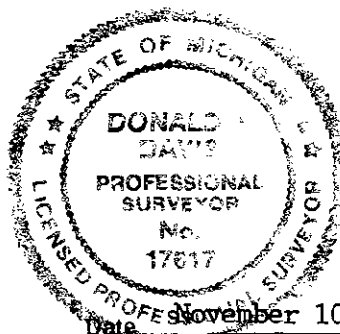

Signed by

Donald J. Davis

Date November 10, 1993

Surveyor's Michigan License No. 17617