

**SURVEY &
REMONUMENTATION**

1993

COMMISSION

CALHOUN COUNTY REMONUMENTATION

**LAND CORNER RECORDATION CERTIFICATE
Filing Requirement of Act 74, Mich. P.A. 1970**

RECORDED

Nov 18 2 22 PM '93

CLERK-REGISTER
CALHOUN COUNTY, MICH.
ANNE B. NORLANDER

For corners in
Calhoun
(County)

Located In: Corner Code #

1. Public Land Survey	T <u>4S.</u> R <u>4W.</u>	<u>E-1</u>
	T _____ R _____	_____
	T _____ R _____	_____
	T _____ R _____	_____
2. Property Controlling in Section	S _____ T _____ R _____	_____
	S _____ T _____ R _____	_____
3. Miscellaneous Property in Sec.	S _____ T _____ R _____	_____
	S _____ T _____ R _____	_____

Register of Deeds Stamp & File Number

4. Lot No. _____, Recorded Plat _____
5. Private Claims _____

Frederick J. Cutcher

I, _____, in a field survey on November 8, 1993, do hereby certify that under requirements of P.A. 74, Michigan P.A. of 1970, the corner points mentioned in lines 1 and 2 above were in conformance with regulations and rules therefore as required in the current manual of survey instructions of the United States Department of the Interior, Bureau of Land Management or by a decree of a Court of Law and/or that the corner points mentioned in lines 3, 4 and 5 above were in conformance with the rules of the Michigan Board of Land Surveyors or by a Decree of a Court of Law; established, re-established, monumented, re-monumented, recovered, found as expressed below:

	A	B	C	D	E	F	G	H	I	J	K	L	M
2	6	5	4	3	2	1							
3													
4	7	8	9	10	11	12							
5													
6	18	17	16	15	14	13							
7													
8	19	20	21	22	23	24							
9													
10	30	29	28	27	26	25							
11													
12	31	32	33	34	35	36							
13													

NOTE: Not more than 4 corners, all in the same town and range, may be recorded on this certificate.

A. Description of original monument and accessories and/or subsequent restoration:
N.E. corner of Sec. 5, T4S, R4W, Homer Twp.

Old records of Calhoun Co. Road Commission (no date of surveyor given): 58 links E.'ly of S.W. cor. Sec. 33, Albion Twp; sleigh shoe: 20" Elm N.E. 86-2/3'; 18" swamp Oak S.E. 194-1/2'

A.H. Chase June 1939: Dug and found sleigh shoe (tipped over) reset with 3/4" iron pipe to surface with stones around: Hickory N.W. 74.2'; 4" Locust N. 2° W. 93.3'; fence cor. N. ab 2° W. 31'. (In 1983 I found 3/4" iron pipe 12" below road surface and set a 1/2" x 12" iron w/cap over it).

B. Description of corner evidence found and/or method applied in restoring or reestablishing corner:


Found 1/2" x 12" iron w/ cap #24592 over 3/4" x 18" iron pipe surrounded by stones over sleigh shoe. Top of sleigh shoe was 22" below road surface.

LIBER 1716 PAGE 448

C. Description of monument for corner and accessories established to perpetuate locating the position of the corner:

Replaced the above with Bernsten stainless steel marker with brass cap in Monument box 2.6'.N. of centerline L Drive S.
P.K. in wood corner post N. 72° E. 71.50'
Top center tel. stan. N. 18° W. 31.98'
P.K. in power pole S. 29° E. 50.11'
38.28' E. of S.W. cor. Sec. 33, Albion Twp.

This corner is accepted as a careful and faithful reestablishment of the position of the original corner.

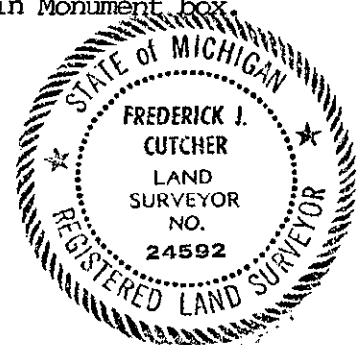

Signed by Frederick J. Cutcher
Surveyor's Michigan License No. 24592

Date November 12, 1993