

SURVEY & REMONUMENTATION

1993

CALHOUN COUNTY REMONUMENTATION

COMMISSION

LAND CORNER RECORDATION CERTIFICATE
Filing Requirement of Act 74, Mich. P.A. 1970

CLERK-REGISTRAR
 CALHOUN COUNTY, MICHIGAN
 ANNE G. YETTS-SANDERS
 SEP 1 11 30 AM '93
 REGISTERED

For corners in
Calhoun
(County)

Located In: Corner Code: #/

1. Public Land Survey T 4S. R 4W. H-3
 T ___ R ___
 T ___ R ___
 T ___ R ___

2. Property Controlling S ___ T ___ R ___
 in Section S ___ T ___ R ___

3. Miscellaneous S ___ T ___ R ___
 Property in Sec. S ___ T ___ R ___

4. Lot No. _____, Recorded Plat _____

5. Private Claims _____

Register of Deeds Stamp & File Number

	A	B	C	D	E	F	G	H	I	J	K	L	M
2	6		5		4		3		2		1		
3								3					
4	7		8		9		10		11		12		
5													
6	18		17		16		15		14		13		
7													
8	19		20		21		22		23		24		
9													
10	30		29		28		27		26		25		
11													
12	31		32		33		34		35		36		
13													

Frederick J. Cutcher

I, _____, in a field survey on August 4, 19 93, do hereby certify that under requirements of P.A. 74, Michigan P.A. of 1970, the corner points mentioned in lines 1 and 2 above were in conformance with regulations and rules therefore as required in the current manual of survey instructions of the United States Department of the Interior, Bureau of Land Management or by a decree of a Court of Law and/or that the corner points mentioned in lines 3, 4 and 5 above were in conformance with the rules of the Michigan Board of Land Surveyors or by a Decree of a Court of Law; established, re-established, monumented, re-monumented, recovered, found as expressed below:

NOTE: Not more than 4 corners, all in the same town and range, may be recorded on this certificate.

A. Description of original monument and accessories and/or subsequent restoration:

Corner common to Sections 3 & 10, Town 4 South, Range 4 West, Homer Twp.
 Iron rod found by Davis Land Surveying in 1982. Origin of iron rod is unknown.
 Lines of occupation were measured by Davis to verify this corner.

B. Description of corner evidence found and/or method applied in restoring or reestablishing corner:


Found 1/2" by 18" iron rod, and accepted this as the best available evidence of the position of the original corner.

C. Description of monument for corner and accessories established to perpetuate locating the position of the corner:

Replaced 1/2" by 18" iron rod with 30" long cast iron Harrison Marker. (Top of Harrison Marker is 6" below gravel road surface).
 Top center of telephone stanchion (leaning) N. 05° W. 27.83'; 7'± South of centerline;
 S.W. corner of house N. 35° W. 102.10'
 center of 10" Walnut N. 55° W. 112.55'
 S.E. corner of house N. 20° W. 82.00'

LIBER 1700 PAGE 143

Signed by Frederick J. Cutcher
 Surveyor's Michigan License No. 24592

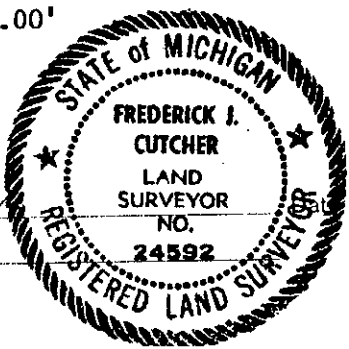

August 23, 1993