

**APPROVED**

Date 5-19-99 RRC

**CALHOUN COUNTY  
REMONUMENTATION.**

**CALHOUN COUNTY REMONUMENTATION  
LAND CORNER RECORDATION CERTIFICATE**  
Filing Requirement of Act 74, Mich. P.A. 1970

STATE OF MICHIGAN  
CALHOUN COUNTY  
RECORDED

14 JUN 1999 1:59:08 PM

For corners in

<u>CALHOUN</u>	Located In:	Corner Code #
(County)		
HOMER TOWNSHIP --		
1. Public Land Survey	T <u>4S</u> R <u>4W</u>	<u>M-1</u>
	T ___ R ___	_____
	T ___ R ___	_____
	T ___ R ___	_____
2. Property Controlling in Section	S ___ T ___ R ___	_____
	S ___ T ___ R ___	_____
3. Miscellaneous Property in Sec.	S ___ T ___ R ___	_____
	S ___ T ___ R ___	_____

ANNE B. NORLANDER  
CLERK - REGISTER OF DEEDS

LIBER **2134** PAGE **502**

Register of Deeds Stamp & File Number

4. Lot No. \_\_\_\_\_, Recorded Plat \_\_\_\_\_  
5. Private Claims \_\_\_\_\_

I, Michael A. Croat, in a field survey on April 2, 1999 do hereby state that under requirements of P.A. 74, Michigan P.A. of 1970, the corner points mentioned in lines 1 and 2 above were in conformance with regulations and rules therefore as required in the current manual of survey instructions of the United States Department of the Interior, Bureau of Land Management or by a decree of a Court of Law and/or that the corner points mentioned in lines 3, 4 and 5 above were in conformance with the rules of the Michigan Board of Land Surveyors or by a Decree of a Court of Law; established, re-established, monumented, recovered, found as expressed below:

NOTE: Not more than 2 corners, all in the same town and range, may be recorded on this certificate.

	A	B	C	D	E	F	G	H	I	J	K	L	M
1													
2		6		5		4		3		2		1	
3													
4		7		8		9		10		11		12	
5													
7													
8		19		20		21		22		23		24	
9													
10		30		29		28		27		26		25	
11													
12		31		32		33		34		35		36	
13													

A. Description of original monument and accessories and/or subsequent restoration:


JOSEPH WAMPLER, DEPUTY SURVEYOR, 1823, SET POST, W. OAK, 16", N 10° E, 14 1/2 LKS. W. OAK, 15", SOUTH, 15 LKS  
A.H. CHASE, 1938, BRICK 14" OAK, EAST, 32.7', 16" HICKORY, S 21° W, 85.8', 8" W. OAK, S 39° E, 45.5'; 14" W. OAK, N 33° W, 44.5'  
RICHARD GUTEKUNST, L.C.R.C. RECORDED IN L. 2, P. 157, JACKSON COUNTY, SET IRON TO SURFACE. FOUND IRON WITH BRICK AROUND.

B. Description of corner evidence found and/or method applied in restoring or reestablishing corner:

FOUND IRON WITH CAP (GUTEKUNST FROM ABOVE). EXCAVATED AND FOUND OLD BRICK. REMAINING WITNESSES FROM ABOVE CHECK, ACCEPTED THIS POSITION AS THE BEST EVIDENCE OF THE ORIGINAL CORNER.

C. Description of monument for corner and accessories established to perpetuate locating the position of the corner:

SET A BERNTSEN MONUMENT IN A MONUMENT BOX WITH CORNER CODE INFORMATION STAMPED IN THE CAP.  
NAIL & TAG IN 22" OAK, S 40° W, 123.08'  
NAIL & TAG IN 22" OAK, N 10° W, 101.03'  
NAIL & TAG IN 18" OAK, S 38° E, 45.94'  
NAIL & TAG IN 25" OAK, N 70° E, 34.32'

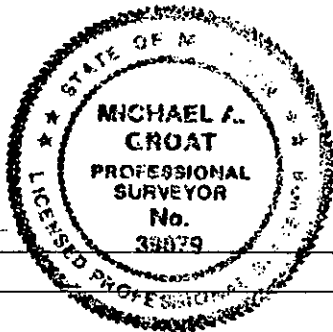

Signed by [Signature]  
Surveyor's Michigan License No. 39079

Date April 6, 1999

**SURVEY &  
REMONUMENTATION**

**MAR 13 2000**

**SECTION**