

**APPROVED**

Date 5-19-99 RRC

CALHOUN COUNTY REMONUMENTATION  
LAND CORNER RECORDATION CERTIFICATE  
Filing Requirement of Act 74, Mich. P.A. 1970

STATE OF MICHIGAN  
CALHOUN COUNTY  
RECORDED

14 JUN 1999 1:59:40 PM

ANNE B. NORLANDER  
CLERK - REGISTER OF DEEDS

LIBER 2134 PAGE 504

Register of Deeds Stamp & File Number

CALHOUN	Located In:	Corner Code #
(County)		
HOMER TOWNSHIP		
1. Public Land Survey	T4S R4W	M-5
	T R	
	T R	
	T R	
2. Property Controlling in Section	S T R	
	S T R	
3. Miscellaneous Property in Sec.	S T R	
	S T R	

4. Lot No. \_\_\_\_\_, Recorded Plat \_\_\_\_\_  
 5. Private Claims \_\_\_\_\_

I, Michael A. Groat, in a field survey on March 30, 1999 do hereby state that under requirements of P.A. 74, Michigan P.A. of 1970, the corner points mentioned in lines 1 and 2 above were in conformance with regulations and rules therefore as required in the current manual of survey instructions of the United States Department of the Interior, Bureau of Land Management or by a decree of a Court of Law and for that the corner points mentioned in lines 3, 4 and 5 above were in conformance with the rules of the Michigan Board of Land Surveyors or by a Decree of a Court of Law; established, re-established, monumented, recovered, found as expressed below:

NOTE: Not more than 2 corners, all in the same town and range, may be recorded on this certificate.

A	B	C	D	E	F	G	H	I	J	K	L	M
1												
2	6		5		4		3		2		1	
3												
4	7		8		9		10		11		12	
5												
6	18		17		16		15		14		13	
7												
8	19		20		21		22		23		24	
9												
10	30		29		28		27		26		25	
11												
12	31		32		33		34		35		36	
13												

A. Description of original monument and accessories and/or subsequent restoration:


ORIGINAL SURVEY, R. CLARK, 1826, SET POST, ASH, 14", S 15-1/2° W, 38 LKS, W. OAK, 7" N 54° W 25 LKS

B. Description of corner evidence found and/or method applied in restoring or reestablishing corner:

FOUND 3/4" PIPE, 40" LONG EXCAVATED & FOUND NOTHING ELSE. AREA HAS BEEN FILLED. PIPE HAS BEEN USED BY AREA SURVEYORS AS THE CORNER. ACCEPTED THIS PIPE AS THE BEST EVIDENCE OF THE ORIGINAL CORNER.

C. Description of monument for corner and accessories established to perpetuate locating the position of the corner:

SET A BERNTSEN MONUMENT IN MONUMENT BOX. STAMPED CORNER CODE INFORMATION IN BRASS CAP.  
 NAIL & TAG IN 18" HICKORY, EAST 47.50'  
 NAIL & TAG IN 25" OAK, N 65° W, 98.61'  
 NAIL & TAG IN 36" OAK, N 15° W, 116.95'  
 NAIL & TAG IN CHERRY, S 46° E, 29.64'

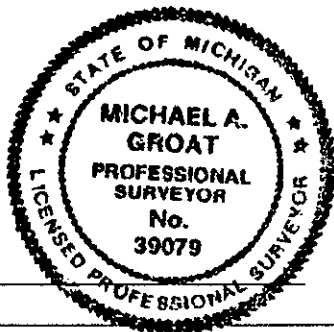

SURVEY & REMONUMENTATION

MAR 18 2000

SECTION

Signed by [Signature]  
 Surveyor's Michigan License No. 39079

Date MARCH 30, 1999