

APPROVED

Date PRLC AUG 18, 1999

CALHOUN COUNTY  
REMONUMENTATION.

CALHOUN COUNTY REMONUMENTATION  
LAND CORNER RECORDATION CERTIFICATE  
Filing Requirement of Act 74, Mich. P.A. 1970

STATE OF MICHIGAN  
CALHOUN COUNTY  
RECORDED

20 AUG 1999 1:25:11 PM

For corners in

CALHOUN  
(County)  
CLARENDON TWP.

Located In:

Corner Code #

1. Public Land Survey		T4S R5 W	A-9
		T _____	_____
		T _____	_____
		T _____	_____
2. Property Controlling in Section	S _____	T _____	_____
	S _____	T _____	_____
3. Miscellaneous Property in Sec.	S _____	T _____	_____
	S _____	T _____	_____

ARNE E. NORLANDER  
CLERK - REGISTER OF DEEDS  
LIBER 2154 PAGE 423

Register of Deeds Stamp & File Number

4. Lot No. \_\_\_\_\_, Recorded Plat \_\_\_\_\_

5. Private Claims \_\_\_\_\_

I, Frederick J. Cutcher, in a field survey on August 17, 1999 do hereby state that under requirements of P.A. 74, Michigan P.A. of 1970, the corner points mentioned in lines 1 and 2 above were in conformance with regulations and rules therefore as required in the current manual of survey instructions of the United States Department of the Interior, Bureau of Land Management or by a decree of a Court of Law and /or that the corner points mentioned in lines 3, 4 and 5 above were in conformance with the rules of the Michigan Board of Land Surveyors or by a Decree of a Court of Law, established, re-established, monumented, recovered, found as expressed below:

NOTE: Not more than 2 corners, all in the same town and range, may be recorded on this certificate.

	A	B	C	D	E	F	G	H	I	J	K	L	M
1													
2	5		5		4		3		2		1		
3													
4	7		8		9		10		11		12		
5													
6	13		17		16		15		14		13		
7													
8	19		20		21		22		23		24		
9													
10	30		29		28		27		26		25		
11													
12	31		32		33		34		35		36		
13													

A. Description of original monument and accessories and/or subsequent restoration:

GLO, 1826, Robert Clark, Jr.: W. Oak 12" N. 22° E. 84 1/2 lks.; W. Oak 14" S. 20° E. 70 lks.

Witness Card, 1997, T.P.J.: 1" solid bar, tile, iron and tie rod end South 29.7'; 8' N. of centerline T Drive S.; U. pole N. 80° E. 43.4'; face conc. pad 56.00'.

Witness Card, 2/28/86, Cutcher: Found R.R. spike 6" below road surface, N. edge T Drive S.

Witness Card, 2/17/97, W. Crane: Found 1 1/2" bar 3' S. of N. edge of pavement, centerline of road S. & E.: S. 70° E. 94.7' 30" W. Oak; N. 40° E. 52.17' Utility Pole; West 177.30' 12" Maple; S. 25° W. 172.34' Utility Pole.

B. Description of corner evidence found and/or method applied in restoring or reestablishing corner:

Found 1 1/2" x 18" solid iron 4" below road surface.

Three of Crane's witnesses remain.

C. Description of monument for corner and accessories established to perpetuate locating the position of the corner:

Replaced 1 1/2" x 18" iron with Berntsen in Monument Box 29.70' North of M-9, Tekonsha, on N. edge of pavement T Drive South and is accepted as the best available evidence of the position of the original corner.


Nail & spotter 12" White Pine N. 7° E. 63.63'; nail & spotter util. pole N. 41° E. 52.18'; nail & spotter 24" Oak S. 71° E. 94.74'; top cen. tel. stan. S. 34° E. 45.40'; nail & spotter util. pole S. 15° W. 172.34'; 29.70' North of M-9 Tekonsha Township.

SURVEY &  
REMONUMENTATION

MAR 13 2000

SECTION

Signed by Frederick J. Cutcher  
Surveyor's Michigan License No. 24592

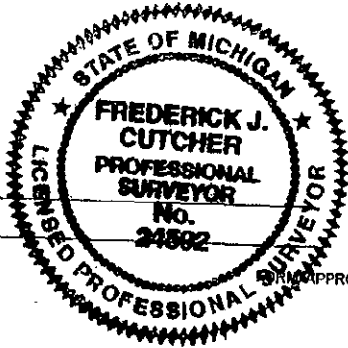

Date 8/18/99

APPROVED BY MICHIGAN STATE BOARD OF PROFESSIONAL SURVEYORS, JAN. 28, 197  
REVISED MAY 14, 197  
REVISED JAN., 198  
REVISED OCT., 199