

APPROVED

Date 11/17/99 RLC
CALHOUN COUNTY
REMONUMENTATION.

CALHOUN COUNTY REMONUMENTATION
LAND CORNER RECORDATION CERTIFICATE
Filing Requirement of Act 74, Mich. P.A. 1970

For corners in

CALHOUN
(County)
CLARENDON TWP.

Located In:

Corner Code #

- 1. Public Land Survey T4S R5 W B-9
- T R
- T R
- T R
- 2. Property Controlling S T R
- in Section S T R
- 3. Miscellaneous S T R
- Property in Sec. S T R

4. Lot No. _____, Recorded Plat _____

5. Private Claims _____

STATE OF MICHIGAN
CALHOUN COUNTY
RECORDED

17 DEC 1999 2:44:11 PM

ANNE B. NORLANDER
CLERK - REGISTER OF DEEDS

LIBER 2185 PAGE 999

Register of Deeds Stamp & File Number

I, Frederick J. Cutcher, in a field survey on August 24, 1999 do hereby state that under requirements of P.A. 74, Michigan P.A. of 1970, the corner points mentioned in lines 1 and 2 above were in conformance with regulations and rules therefore as required in the current manual of survey instructions of the United States Department of the Interior, Bureau of Land Management or by a decree of a Court of Law and /or that the corner points mentioned in lines 3, 4 and 5 above were in conformance with the rules of the Michigan Board of Land Surveyors or by a Decree of a Court of Law; established, re-established, monumented, recovered, found as expressed below:

NOTE: Not more than 2 corners, all in the same town and range, may be recorded on this certificate.

A. Description of original monument and accessories and/or subsequent restoration:

GLO, Robert Clark, Jr., 1825: 12" Cherry N. 73° E. 97 lks.; 40" W. Oak S. 66° W. 94 lks.

Arndts, 1928: 18" Poplar S. 35° W. 50.6'; 20" Poplar S. 60° W. 82.0'; 18" Maple N. 65° W. 130.0'; 20" Apple N. 60° E. 74.1'.

Davis, 1977: (Survey Drawing) R.R. Spike over rock; Util. Pole N. 35° W. 62.75'; 18" Maple S. 55° W. 53.73'; Util. Pole S. 42° W. 44.80'.

Cutcher, 1986: Replaced R.R. Spike found with 1/2" x 12" iron w/cap; in centerline intersection of roads.

Crane, 1997: Found iron rod centerline intersection of roads; Util. Pole N. 40° W. 61.55'; Util. Pole S. 45° W. 47.11'; 30" Maple S. 25° W. 84.46'; 28" Hickory N. 70° E. 133.28'.

B. Description of corner evidence found and/or method applied in restoring or reestablishing corner:

Found 1/2" x 12" iron, all of Crane's references remain; no references of Arndts remain; Davis' references do not quite fit this corner; this corner is on line with A-9 and C-9.

C. Description of monument for corner and accessories established to perpetuate locating the position of the corner:


Replaced iron found with Berntsen Monument in Monument Box and is accepted as the best available evidence of the position of the original corner.

In centerline intersection of roads; Nail & Spotter 30" Hickory N. 82° E. 132.38'; Nail & Spotter 30" Maple S. 18° W. 84.45'; Nail & Spotter Pwr. Pole S. 43° W. 47.22'; Nail & Spotter Pwr. Pole N. 30° W. 61.55'; Top cen. Tel. Stan. S. 43° W. 46.30'.

1	A	B	C	D	E	F	G	H	I	J	K	L	M
2		6		5		4		3		2		1	
3													
4		7		8		9		10		11		12	
5													
6		18		17		16		15		14		13	
7													
8		19		20		21		22		23		24	
9		●											
10		30		29		28		27		26		25	
11													
12		31		32		33		34		35		36	
13													

Signed by Frederick J. Cutcher
Surveyor's Michigan License No. 24592

Date 11/15/99

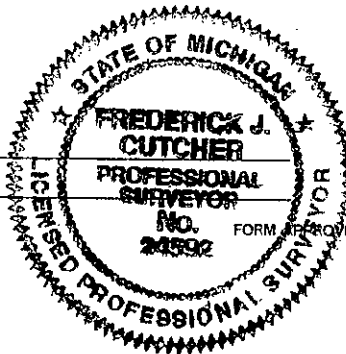

SURVEY &
REMONUMENTATION

MAR 13 2000

SECTION

FORM APPROVED BY MICHIGAN STATE BOARD OF PROFESSIONAL SURVEYORS, JAN. 28, 197
REVISED MAY 14, 197
REVISED JAN., 198
REVISED OCT., 199