

APPROVED

Date 6-15-94
**CALHOUN COUNTY
REMONUMENTATION.**

**CALHOUN COUNTY REMONUMENTATION
LAND CORNER RECORDATION CERTIFICATE
Filing Requirement of Act 74, Mich. P.A. 1970**

For corners in
Calhoun
(County)

Located In: Corner Code #

- | | | | | | | | |
|------------------------------------|---|----------|---|---|----------|---|-----|
| 1. Public Land Survey | T | <u>4</u> | S | R | <u>5</u> | W | E-3 |
| | T | | | R | | | |
| | T | | | R | | | |
| | T | | | R | | | |
| 2. Property Controlling in Section | S | | T | | R | | |
| | S | | T | | R | | |
| 3. Miscellaneous Property in Sec. | S | | T | | R | | |
| | S | | T | | R | | |
4. Lot No. _____, Recorded Plat _____
5. Private Claims _____

STATE OF MICHIGAN
CALHOUN COUNTY
RECORDED

16 JUN 94 9:08 A.M.

ANNE B. NORLANDER
CLERK - REGISTER OF DEEDS

Register of Deeds Stamp & File Number

	A	B	C	D	E	F	G	H	I	J	K	L	M
2	6		5		4		3		2		1		
3					●								
4	7		8		9		10		11		12		
5													
6	18		17		16		15		14		13		
7													
8	19		20		21		22		23		24		
9													
10	30		29		28		27		26		25		
11													
12	31		32		33		34		35		36		
13													

I, Donald J. Davis, in a field survey on April 30, 1994, 19_____, do hereby certify that under requirements of P.A. 74, Michigan P.A. of 1970, the corner points mentioned in lines 1 and 2 above were in conformance with regulations and rules therefore as required in the current manual of survey instructions of the United States Department of the Interior, Bureau of Land Management or by a decree of a Court of Law and/or that the corner points mentioned in lines 3, 4 and 5 above were in conformance with the rules of the Michigan Board of Land Surveyors or by a Decree of a Court of Law; established, re-established, monumented, re-monumented, recovered, found as expressed below:

NOTE: Not more than 4 corners, all in the same town and range, may be recorded on this certificate.

A. Description of original monument and accessories and/or subsequent restoration:

Original government survey.
24" Burr Oak S 47° W, 64½ links.
18" White Oak N 13½° E, 68 links.

**SURVEY &
REMONUMENTATION
OCT 24 1994
COMMISSION**


B. Description of corner evidence found and/or method applied in restoring or reestablishing corner:

Found capped iron with License No. 24592 (Fred Cutcher)
Dug and found old plow point.

LIBER 1753 PAGE 720

C. Description of monument for corner and accessories established to perpetuate locating the position of the corner:

Set Harrison monument.
Nail & Spotter in 12" Maple, South 25.24'.
Nail & Spotter in 10" Maple, North 32.5'.
Nail & Spotter in 8" Maple, S 40° E, 51.45'.
Nail & Spotter in 12" Maple, N 85° W, 170.70'.

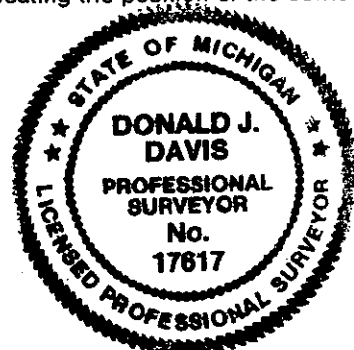

Signed by Donald J. Davis
Surveyor's Michigan License No. 17617

Date June 14, 1994