

**APPROVED**

Date 6-15-94 WJD  
**CALHOUN COUNTY  
REMONUMENTATION.**


CALHOUN COUNTY REMONUMENTATION

**LAND CORNER RECORDATION CERTIFICATE**  
Filing Requirement of Act 74, Mich. P.A. 1970

For corners in

<u>Calhoun</u> <small>(County)</small>	Located In:	Corner Code #
1. Public Land Survey	T <u>4</u> S R <u>5</u> W	<u>E-5</u>
	T _____ R _____	_____
	T _____ R _____	_____
	T _____ R _____	_____
2. Property Controlling in Section	S _____ T _____ R _____	_____
	S _____ T _____ R _____	_____
3. Miscellaneous Property in Sec.	S _____ T _____ R _____	_____
	S _____ T _____ R _____	_____
4. Lot No. _____, Recorded Plat _____		
5. Private Claims _____		

STATE OF MICHIGAN  
CALHOUN COUNTY  
RECORDED  
16 JUN 94 9:08 A.M.  
ANNE B. NORLANDER  
Register of Deeds Stamp & File Number  
CLERK REGISTER OF DEEDS

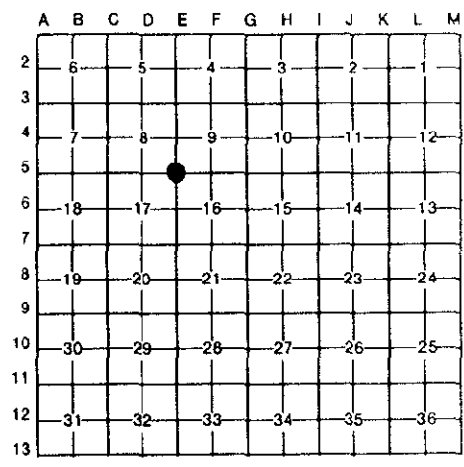

I, Donald J. Davis, in a field survey on April 30, 19 94, do hereby certify that under requirements of P.A. 74, Michigan P.A. of 1970, the corner points mentioned in lines 1 and 2 above were in conformance with regulations and rules therefore as required in the current manual of survey instructions of the United States Department of the Interior, Bureau of Land Management or by a decree of a Court of Law and/or that the corner points mentioned in lines 3, 4 and 5 above were in conformance with the rules of the Michigan Board of Land Surveyors or by a Decree of a Court of Law; established, re-established, monumented, re-monumented, recovered, found as expressed below:

**NOTE: Not more than 4 corners, all in the same town and range, may be recorded on this certificate.**

A. Description of original monument and accessories and/or subsequent restoration:  
Original government survey  
14" Burr Oak N 71° E, 152 links  
14" White Oak S 56½° W, 75 links

**SURVEY &  
REMONUMENTATION**  
OCT 24 1994  
COMMISSION

B. Description of corner evidence found and/or method applied in restoring or reestablishing corner:  
Found boat spike, dug and found several large rocks.

LIBER 1753 PAGE 719

C. Description of monument for corner and accessories established to perpetuate locating the position of the corner:  
Set Harrison monument.  
Nail & Spotter 18" Oak N 80° E 23.58'.  
Nail & Spotter 18" Oak S 45° E 28.70'.  
Nail & Spotter Telephone pole mail box, West, 17.20'.  
Westerly corner of concrete culvert wall, N 10° E, 99.5'.



Signed by Donald J. Davis Date June 14, 1994  
Surveyor's Michigan License No. 17617