

APPROVED

Date 7-27-94  
CALHOUN COUNTY  
REMONUMENTATION.

CALHOUN COUNTY REMONUMENTATION  
LAND CORNER RECORDATION CERTIFICATE  
Filing Requirement of Act 74, Mich. P.A. 1970

For corners in  
Calhoun  
(County)

Located In:	Corner Code #
T <u>4</u> S R <u>5</u> W	<u>F-3</u>
T _____ R _____	_____
T _____ R _____	_____
T _____ R _____	_____
S _____ T _____ R _____	_____
S _____ T _____ R _____	_____
S _____ T _____ R _____	_____
S _____ T _____ R _____	_____


STATE OF MICHIGAN  
CALHOUN COUNTY  
RECORDED

28 JUL 94 11:15 A.M.

ANNE S. NORLAUNDER  
CLERK - REGISTER OF DEEDS

Register of Deeds Stamp & File Number

- 4. Lot No. \_\_\_\_\_, Recorded Plat \_\_\_\_\_
- 5. Private Claims \_\_\_\_\_

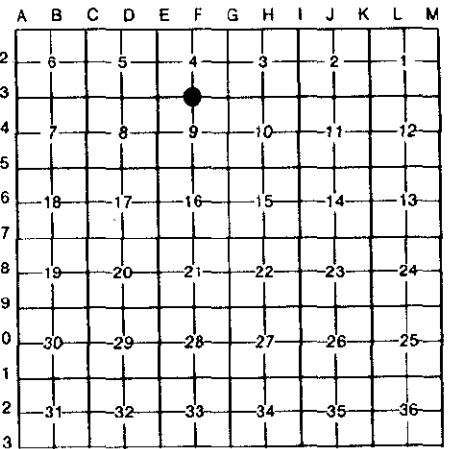

Donald J. Davis, in a field survey on JULY 7, 19 94, do hereby certify that under requirements of P.A. 74, Michigan P.A. of 1970, the corner points mentioned in lines 1 and 2 above were in conformance with regulations and rules therefore as required in the current manual of survey instructions of the United States Department of the Interior, Bureau of Land Management or by a decree of a Court of Law and/or that the corner points mentioned in lines 3, 4 and 5 above were in conformance with the rules of the Michigan Board of Land Surveyors or by a Decree of a Court of Law: established, re-established, monumented, re-monumented, recovered, found as expressed below:

NOTE: Not more than 4 corners, all in the same town and range, may be recorded on this certificate.

A. Description of original monument and accessories and/or subsequent restoration:  
Clark, 1826; Original Survey.

SURVEY &  
REMONUMENTATION

OCT 24 1994


COMMISSION

B. Description of corner evidence found and/or method applied in restoring or reestablishing corner:  
Set corner on occupation East and West on line between NE corner of Section 10 and NW corner of Section 9.

No original witnesses remain. Excavated in road and found no evidence of corner.

C. Description of monument for corner and accessories established to perpetuate locating the position of the corner:  
Set Harrison monument.

- Nail & Spotter 24" Popler N 60° E 47.80'
- Nail & Spotter 24" Hickory N 60° W 38.90'
- Nail & Spotter 24" Oak N 80° E 16.50'
- Nail & Spotter 12" Popler North 68.60'

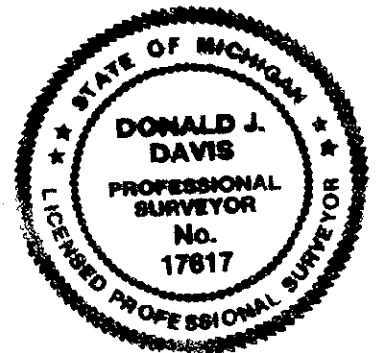

Signed by Donald J. Davis  
Surveyor's Michigan License No. 17617

Date July 25, 1994