

APPROVED

Date 11/17/99 REC
CALHOUN COUNTY
REMONUMENTATION.

CALHOUN COUNTY REMONUMENTATION
LAND CORNER RECORDATION CERTIFICATE
Filing Requirement of Act 74, Mich. P.A. 1970

STATE OF MICHIGAN
CALHOUN COUNTY
RECORDED

For corners in

CALHOUN
(County)
CLARENDON TWP.

Located In: Corner Code #

17 DEC 1999 2:45:30 PM

ANNE B. NORLANDER
CLERK - REGISTER OF DEEDS

LIBER 2186 PAGE 3

Register of Deeds Stamp & File Number

1. Public Land Survey		T4S R5 W	F-9
		T R	
		T R	
		T R	
2. Property Controlling in Section	S	T R	
	S	T R	
3. Miscellaneous Property in Sec.	S	T R	
	S	T R	

4. Lot No. _____, Recorded Plat _____

5. Private Claims _____

I, Frederick J. Cutcher, in a field survey on August 24, 1999 do hereby state that under requirements of P.A. 74, Michigan P.A. of 1970, the corner points mentioned in lines 1 and 2 above were in conformance with regulations and rules therefore as required in the current manual of survey instructions of the United States Department of the Interior, Bureau of Land Management or by a decree of a Court of Law and /or that the corner points mentioned in lines 3, 4 and 5 above were in conformance with the rules of the Michigan Board of Land Surveyors or by a Decree of a Court of Law, established, re-established, monumented, recovered, found as expressed below:

NOTE: Not more than 2 corners, all in the same town and range, may be recorded on this certificate.

	A	B	C	D	E	F	G	H	I	J	K	L	M
1													
2		6		5		4		3		2		1	
3													
4		7		8		9		10		11		12	
5													
6		18		17		16		15		14		13	
7													
8		19		20		21		22		23		24	
9													
10		30		29		28		27		26		25	
11													
12		31		32		33		34		35		36	
13													

A. Description of original monument and accessories and/or subsequent restoration:

GLO, Robert Clark, Jr., 1825: 7" Tamarack N. 18° W. 10 lks.; 9" Tamarack S. 47° E. 12-1/2 lks.

No other information since GLO.

B. Description of corner evidence found and/or method applied in restoring or reestablishing corner:

Established corner half way and on line with E-9 and G-9.

C. Description of monument for corner and accessories established to perpetuate locating the position of the corner:

Set Berntsen Monument in Monument Box and is accepted as the best available evidence of the position of the original corner.

4' North of centerline E/W road; 1.5' West of steel post to South; in line with field line to North. Iron w/cap N. 25° W. 11.27'; Iron w/cap N. 53° E. 14.44'; iron w/cap S. 57° W. 28.88'; Top center round steel post South 28.43'.


Signed by Frederick J. Cutcher
Surveyor's Michigan License No. 24592

Date 11/15/99

SURVEY &
REMONUMENTATION

MAR 13 2000

SECTION

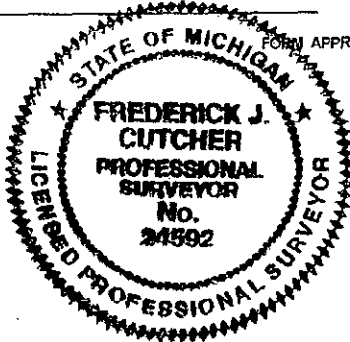

FORM APPROVED BY MICHIGAN STATE BOARD OF PROFESSIONAL SURVEYORS, JAN. 28, 197
REVISED MAY 14, 197
REVISED JAN., 196
REVISED OCT., 199