

MAR 30 1999

APPROVED

Date 7-15-98 *RLC*  
CALHOUN COUNTY  
REMONUMENTATION.

CALHOUN COUNTY REMONUMENTATION  
LAND CORNER RECORDATION CERTIFICATE  
Filing Requirement of Act 74, Mich. P.A. 1970

STATE OF MICHIGAN  
CALHOUN COUNTY  
RECORDED

20 JUL 1998 1:53:54 PM

For corners in

Calhoun _____	Located in:	Corner Code #
(County)		
CLARENDON		
1. Public Land Survey	T <u>4S</u> R <u>5W</u>	<u>G-2</u>
	T _____ R _____	_____
	T _____ R _____	_____
	T _____ R _____	_____
2. Property Controlling in Section	S _____ T _____ R _____	_____
	S _____ T _____ R _____	_____
3. Miscellaneous Property in Sec.	S _____ T _____ R _____	_____
	S _____ T _____ R _____	_____

ANNE B. NORLANDER  
CLERK - REGISTER OF DEEDS  
LIBER **2044** PAGE **156**

Register of Deeds Stamp & File Number

4. Lot No. \_\_\_\_\_, Recorded Plat \_\_\_\_\_  
5. Private Claims \_\_\_\_\_

I, Michael A. Groat, in a field survey on November, 1997 do hereby state that under requirements of P.A. 74, Michigan P.A. of 1970, the corner points mentioned in lines 1 and 2 above were in conformance with regulations and rules therefore as required in the current manual of survey instructions of the United States Department of the Interior, Bureau of Land Management or by a decree of a Court of Law and for that the corner points mentioned in lines 3, 4 and 5 above were in conformance with the rules of the Michigan Board of Land Surveyors or by a Decree of a Court of Law; established, re-established, monumented, recovered, found as expressed below:

NOTE: Not more than 2 corners, all in the same town and range, may be recorded on this certificate.

1	A	B	C	D	E	F	G	H	I	J	K	L	M
2	6		5			4	3		2		1		
3													
4	7		8			9	10		11		12		
5													
6	13		17			16	15		14		13		
7													
8	19		20			21	22		23		24		
9													
10	30		29			28	27		26		25		
11													
12	31		32			33	34		35		36		
13													

A. Description of original monument and accessories and/or subsequent restoration:


Original Survey in 1826 by Robert Clark Jr.  
Set post, W. Oak 10', S 14° W, 29 1/2 LKS, W. Oak, 24" S 87° E, 4 1/2 LKS  
Courtright, 1895, Angular Stone with Bricks. W. Oak 10" S 14° W, 29 1/2 LKS, W. Oak, 24" S 87° E, 4 1/2 LKS

B. Description of corner evidence found and/or method applied in restoring or reestablishing corner:

Traversed from the southeast to northeast corners of Section 4. We measure the mile at 5141.32 feet. The last 1/4 mile was 17.29 chains which prorates out to 1150.13 feet. Visiting the approximate location of the corner, we found a large angled rock. Digging the smaller rocks from around it we found pieces of crockery. Did not find any brick. This corner measures 2659.39 feet north of the SE corner of the section and the proportionate distance is 2660.79'.  
Accepted the angled stone as a careful & faithful perpetuation of the original corner.

C. Description of monument for corner and accessories established to perpetuate locating the position of the corner:

Set Bernsten monument with carsonite marker 1'± East stamped corner code information in Brass Cap  
Nail & Tag in E'ly side of 20" Cherry, 330° NAZ, 5.95'  
Nail & Tag in W'ly side of 10" Oak, 190° NAZ, 21.6'  
Nail & Tag in N'ly side of 10" Hickory, 256° NAZ, 23.1'  
R.R. Iron fence corner, 40° NAZ, 4.15'

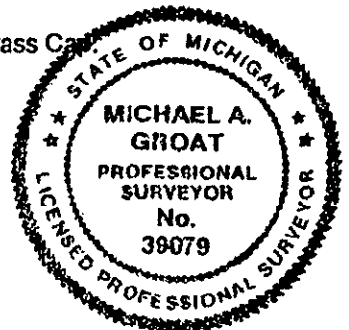

NAZ = magnetic azimuth measured from north.

Signed by [Signature]  
Surveyor's Michigan License No. 39079

Date May 21, 1998