

APPROVED

Date 7-27-94
CALHOUN COUNTY
REMONUMENTATION.

CALHOUN COUNTY REMONUMENTATION
LAND CORNER RECORDATION CERTIFICATE
Filing Requirement of Act 74, Mich. P.A. 1970

For corners in

Calhoun
(County)

Located In:

Corner Code #

1. Public Land Survey	T	<u>4</u>	S	R	<u>5</u>	W	<u>G-3</u>
	T	_____	R	_____	_____	_____	_____
	T	_____	R	_____	_____	_____	_____
	T	_____	R	_____	_____	_____	_____
2. Property Controlling in Section	S	_____	T	_____	R	_____	_____
	S	_____	T	_____	R	_____	_____
3. Miscellaneous Property in Sec.	S	_____	T	_____	R	_____	_____
	S	_____	T	_____	R	_____	_____


STATE OF MICHIGAN
CALHOUN COUNTY
RECORDED

28 JUL 94 11:15 A.M.

ANNE B. NORLANDER
CLERK - REGISTER OF DEEDS

Register of Deeds Stamp & File Number

4. Lot No. _____, Recorded Plat _____
5. Private Claims _____

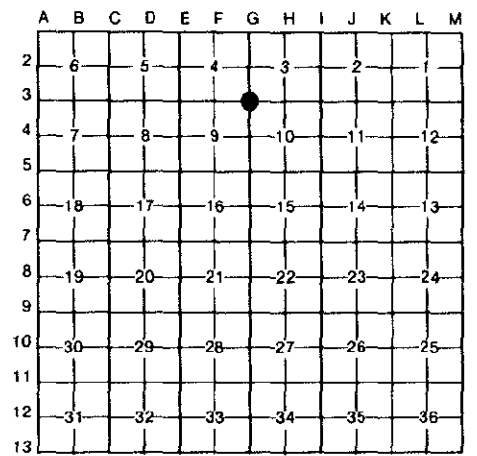

I, Donald J. Davis in a field survey on July 7, 1994, do hereby certify that under requirements of P.A. 74, Michigan P.A. of 1970, the corner points mentioned in lines 1 and 2 above were in conformance with regulations and rules therefore as required in the current manual of survey instructions of the United States Department of the Interior, Bureau of Land Management or by a decree of a Court of Law and/or that the corner points mentioned in lines 3, 4 and 5 above were in conformance with the rules of the Michigan Board of Land Surveyors or by a Decree of a Court of Law; established, re-established, monumented, re-monumented, recovered, found as expressed below:

NOTE: Not more than 4 corners, all in the same town and range, may be recorded on this certificate.

A. Description of original monument and accessories and/or subsequent restoration:
Clark, 1826.

- 12" B. Ash S 56-3/4° E 358 Links
- 5" B. Ash N 53-3/4° E 561 Links

B. Description of corner evidence found and/or method applied in restoring or reestablishing corner:

Original corner destroyed by drain construction.
Set corner on occupation East & West on line between NE corner of Section 10 and NW corner of Section 9.

SURVEY &
REMONUMENTATION


OCT 24 1994

COMMISSION

LIBER 1760 PAGE 647

C. Description of monument for corner and accessories established to perpetuate locating the position of the corner:

Set Harrison monument, 4' West of centerline of culvert in drain, no witnesses near.
2657.64' East of North 1/4 Post of Section 9
2650.01' North of East 1/4 Post of Section 9
2650.26' West of North 1/4 Post of Section 10.

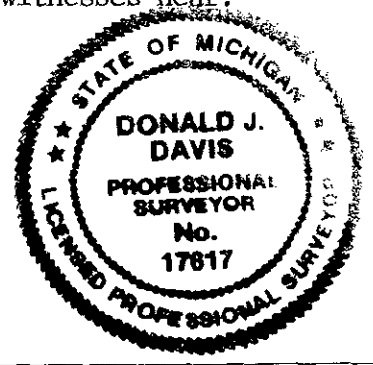

Signed by Donald J. Davis

Date July 25, 1994

Surveyor's Michigan License No. 17817